

---

Title:

Drawings for TIC 711

---

 **REGNECENTRALEN**

RC SYSTEM LIBRARY: FALKONERALLE 1 DK-2000 COPENHAGEN F

---

RCSL No: 44-RT 1854

Edition: February 1979

Author: Karsten Friis.

---

Keywords: CHS 701, Second Teletype Controller.

---

Abstract: This paper contains the drawings of TTC 711 Teletype Controller.

---

Copyright A/S Regnecentralen, 1978  
Printed by A/S Regnecentralen, Copenhagen

Users of this manual are cautioned that the specifications contained herein are subject to change by RC at any time without prior notice. RC is not responsible for typographical or arithmetic errors which may appear in this manual and shall not be responsible for any damages caused by reliance on any of the materials presented.

---

<u>CONTENTS</u>	<u>PAGE</u>
INTRODUCTION .....	1
CABLE ASSEMBLY DRAWING .....	2
CABLE CBL 194 .....	3
SELECTION OF DEVICE CODE .....	4
SELECTION OF SPEED .....	5
DRAWINGS FOR TTC 711 PAGE 1 - 5 .....	6
PCB ASSEMBLY DRAWING RC2324 (A 3) .....	11




INTRODUCTION.

The TTC 711 is a revised edition of the TTC 706. The two controllers are identical but for a minor change enabling the TTC 711 to run 9600 BPS.

The TTC 711 must be mounted on the PC board containing the IOC 707 which provides the BUS interface for the TTC 711.

All references to diagrams marked IOC or RTC are to diagrams in the IOC 707 controller.



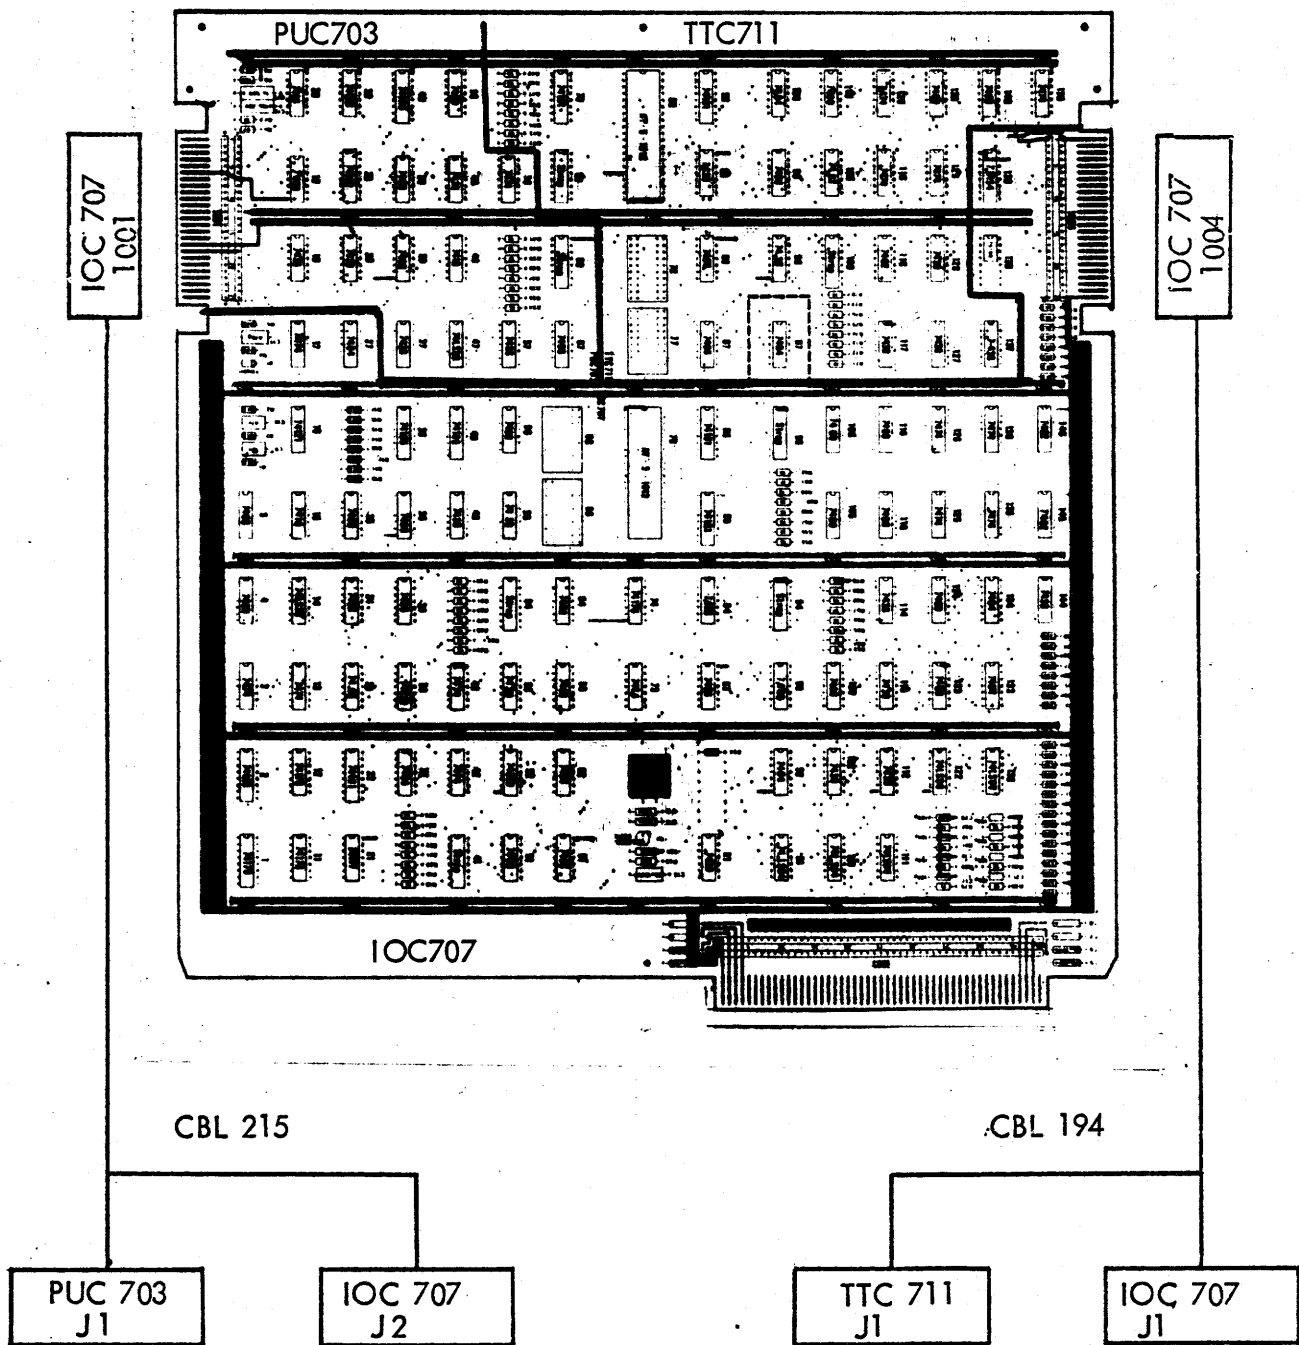

IOC 707 J1 : Teletype  
 IOC 707 J2 : Paper Tape Reader





CONNECTOR:

IOC 707 - 1004

IOC 707 - J1

TTC 711 - J1

: Edgeconnector 2 x 25 contacts

: Cannon DEC - 95

: Cannon DEC - 95

First Teletype

IOC 707 1004		IOC 707 J1
A 17	REC DATA	3
A 19	SELSTOP	8
A 21	CTS	5
A 23	XMT DATA	6
B 25	OV	9
A 25	+ 5V	1

Second Teletype

IOC 707 1004		TTC 711 J1
B 1	OV	9
A 3	XMT DATA	6
A 5	CTS	5
A 7	SELSTOP	8
A 9	REC DATA	3
A 1	+ 5V	1




DEVICE CODE (position 108)

1. Teletype

TTI ~ 10<sub>8</sub>


TTO ~ 11<sub>8</sub>

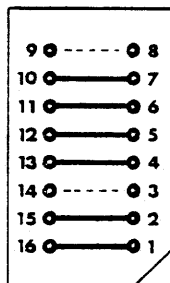

2. Teletype

TTI ~ 50<sub>8</sub>

TTO ~ 51<sub>8</sub>

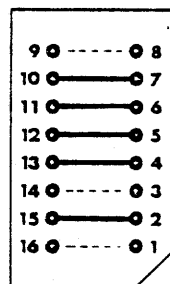

OBS! It is only possible to select the device code for TTI and TTO after the following equations:

$$\left. \begin{aligned} \text{Device code TTI:} &= 2 * N \\ \text{Device code TTO:} &= 2 * N + 1 \end{aligned} \right\} 1_8 \leq N < 40_8$$

Replaced by Dwg. No.      due to ECN      Replaces Dwg. No.      Design Check      Dwg. Office Check      Drawn by      Designed by  
 18.07.77.MOJ


RC 63c: VB 139

A/S REGNOCENTRALEN


Unit TTC 711	SELECTION OF DEVICE CODE Strapping form	1/1
Dwg. No.		




SPEED (position 69)

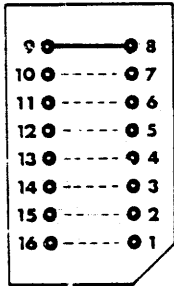


4800 BPS

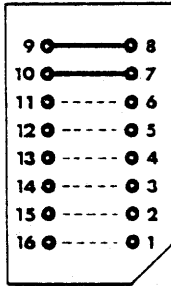


2400 BPS

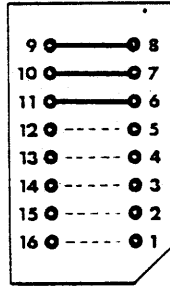


1200 BPS

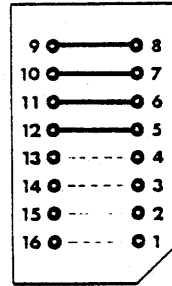


600 BPS

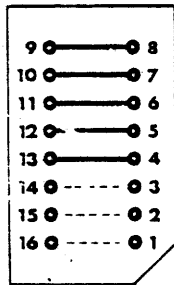


300 BPS

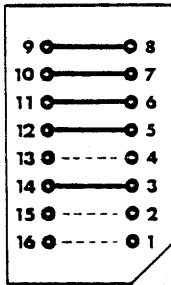

200 BPS

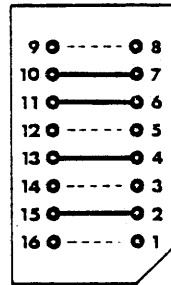

110 BPS

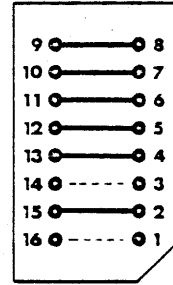

100 BPS

To select 9600 BPS the strap platform in position 69 is not used.  
 Instead the strap platform in position 108 is changed:

- Remove strap 10 - 7
- Remove strap 11 - 6
- Insert strap 6 - 7 - 9


Replaced by Dwg. No.  
 due to ECN  
 Replaces Dwg. No.  
 Design Check  
 Dwg. Office Check  
 Drawn by  
 Designed by  
**A/S REGNOCENTRALEN**  
 18.07.77 MOJ  
 VB 119

Unit	TTC 711
Dwg. No.	

SELECTION OF SPEED	
Strapping form	

1/1
-----




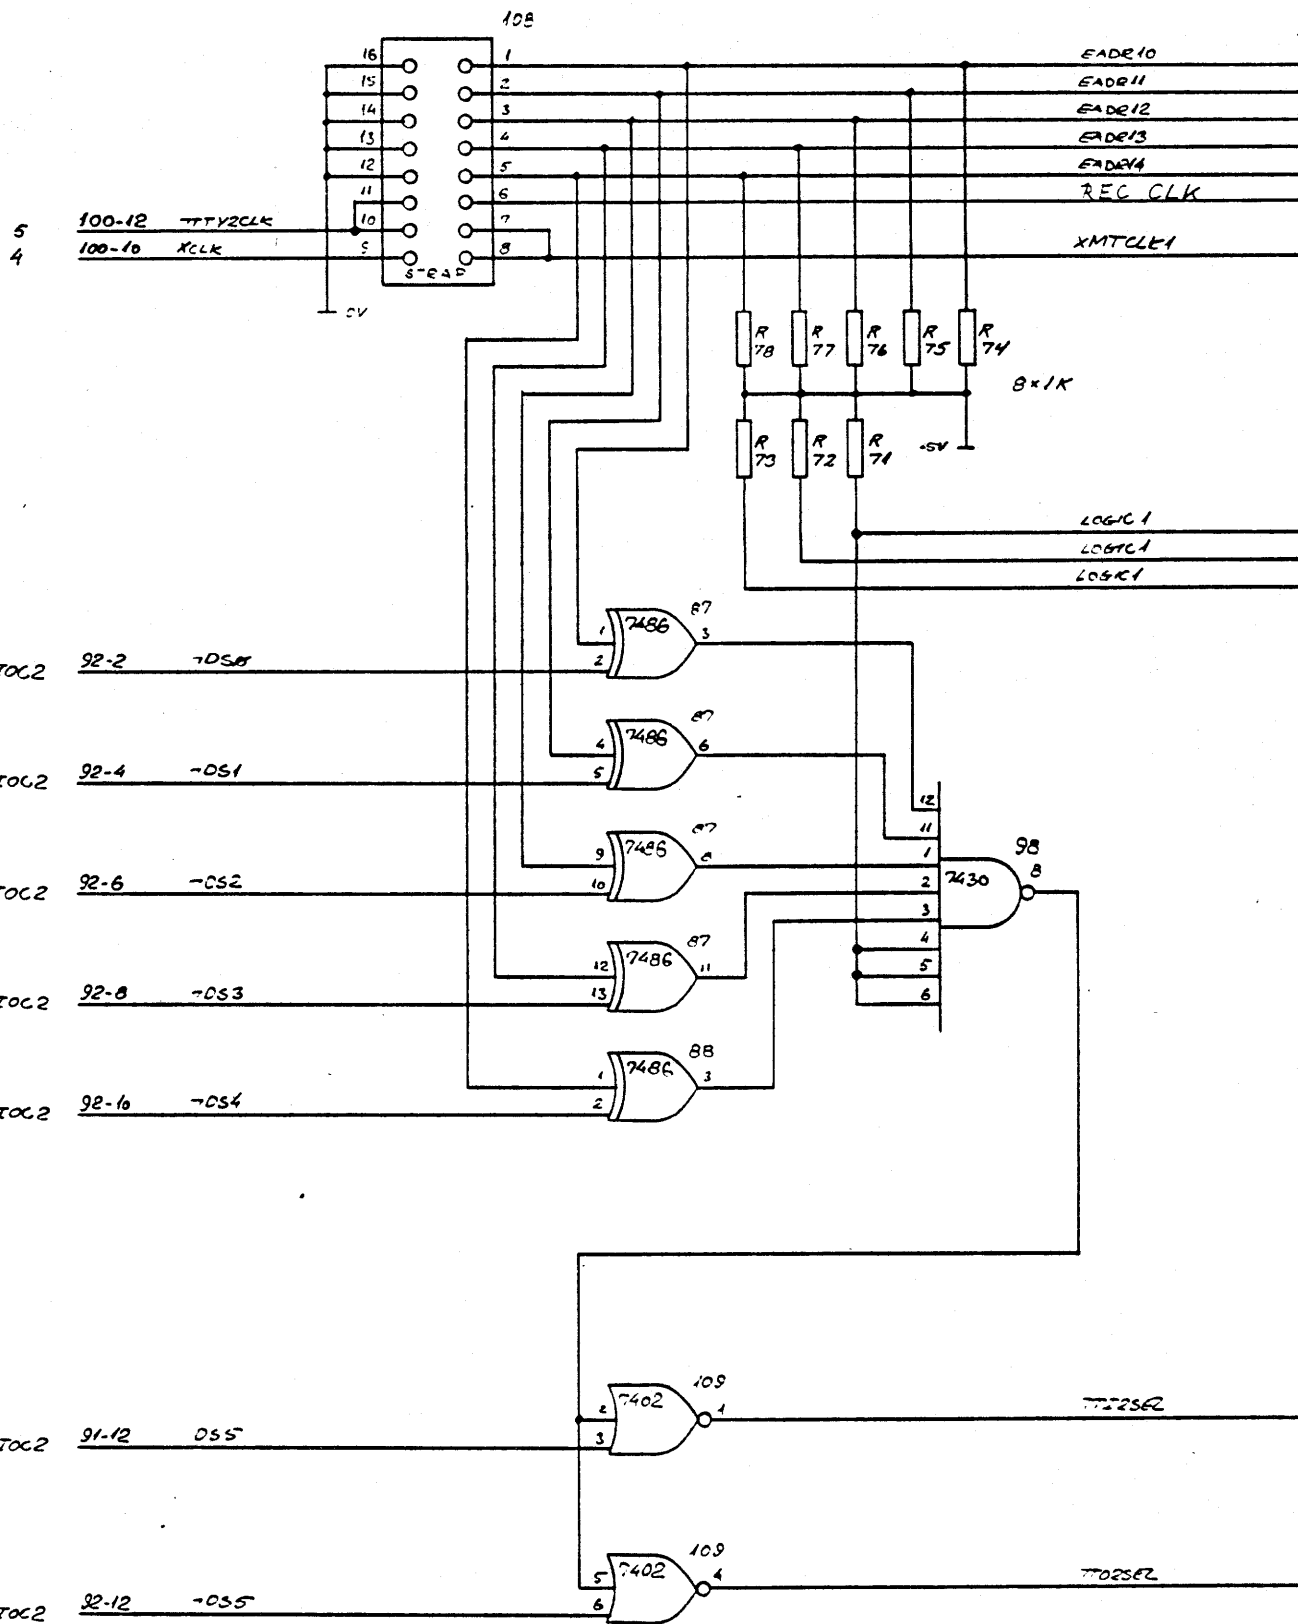


Replaces Dwg. No. \_\_\_\_\_  
 due to ECN \_\_\_\_\_  
 Replaces Dwg. No. R 12070  
 Design Check \_\_\_\_\_  
 Dwg. Office Check \_\_\_\_\_  
 Drawn by \_\_\_\_\_  
 Designed by JJO 75.08.11  
**A/S REGNENTRALEN**

Unit TTC 711	SELECT LOGIC	TTC
Dwg. No. R 12652	LOGIC DIAGRAM	1






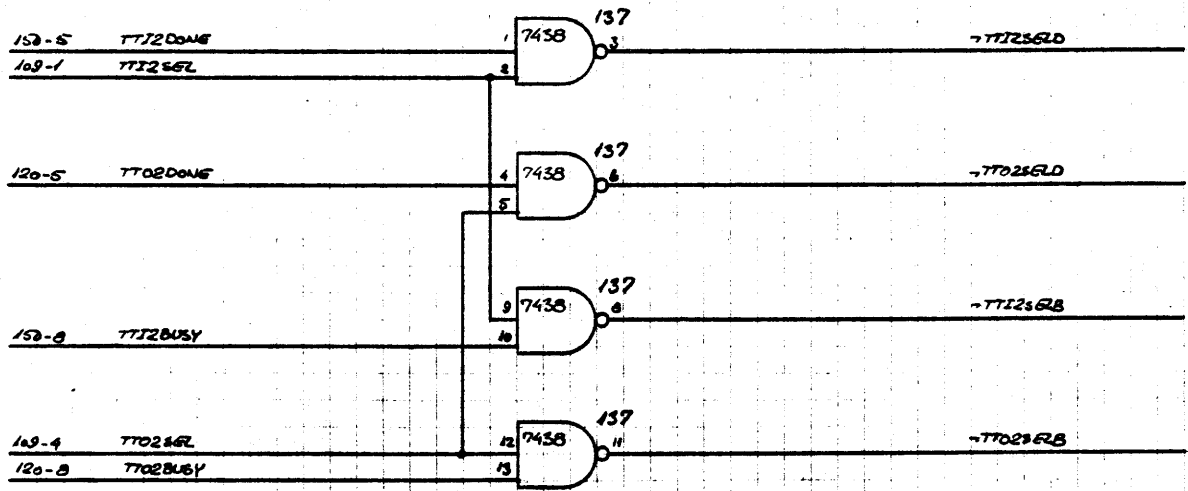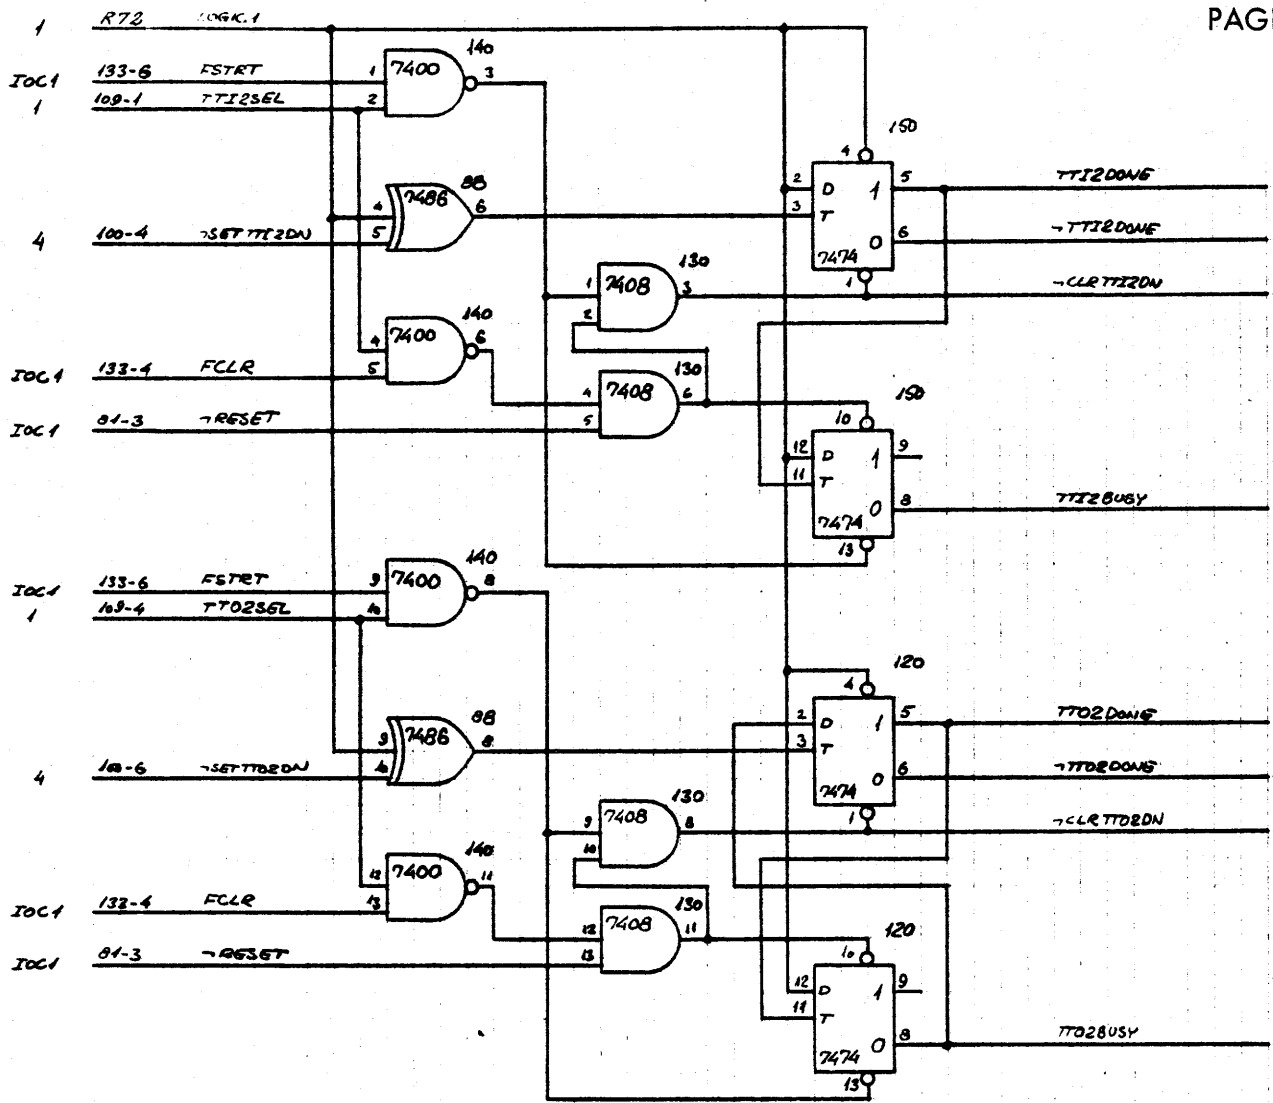

Replaced by Dwg. No. **R11188**  
 due to ECN  
 Replaces Dwg. No. **R11188**  
 Design Check  
 Dwg. Office Check  
 Drawn by  
 Designed by **75.02.04 JJO**  
**A/S REGNENTRALEN**


Unit <b>TTC 711</b>	<b>TELETYPE BUSY AND DONE LOGIC</b>	<b>TTC</b> <b>2</b>
Dwg. No. <b>R12073</b>		
<b>LOGIC DIAGRAM</b>		




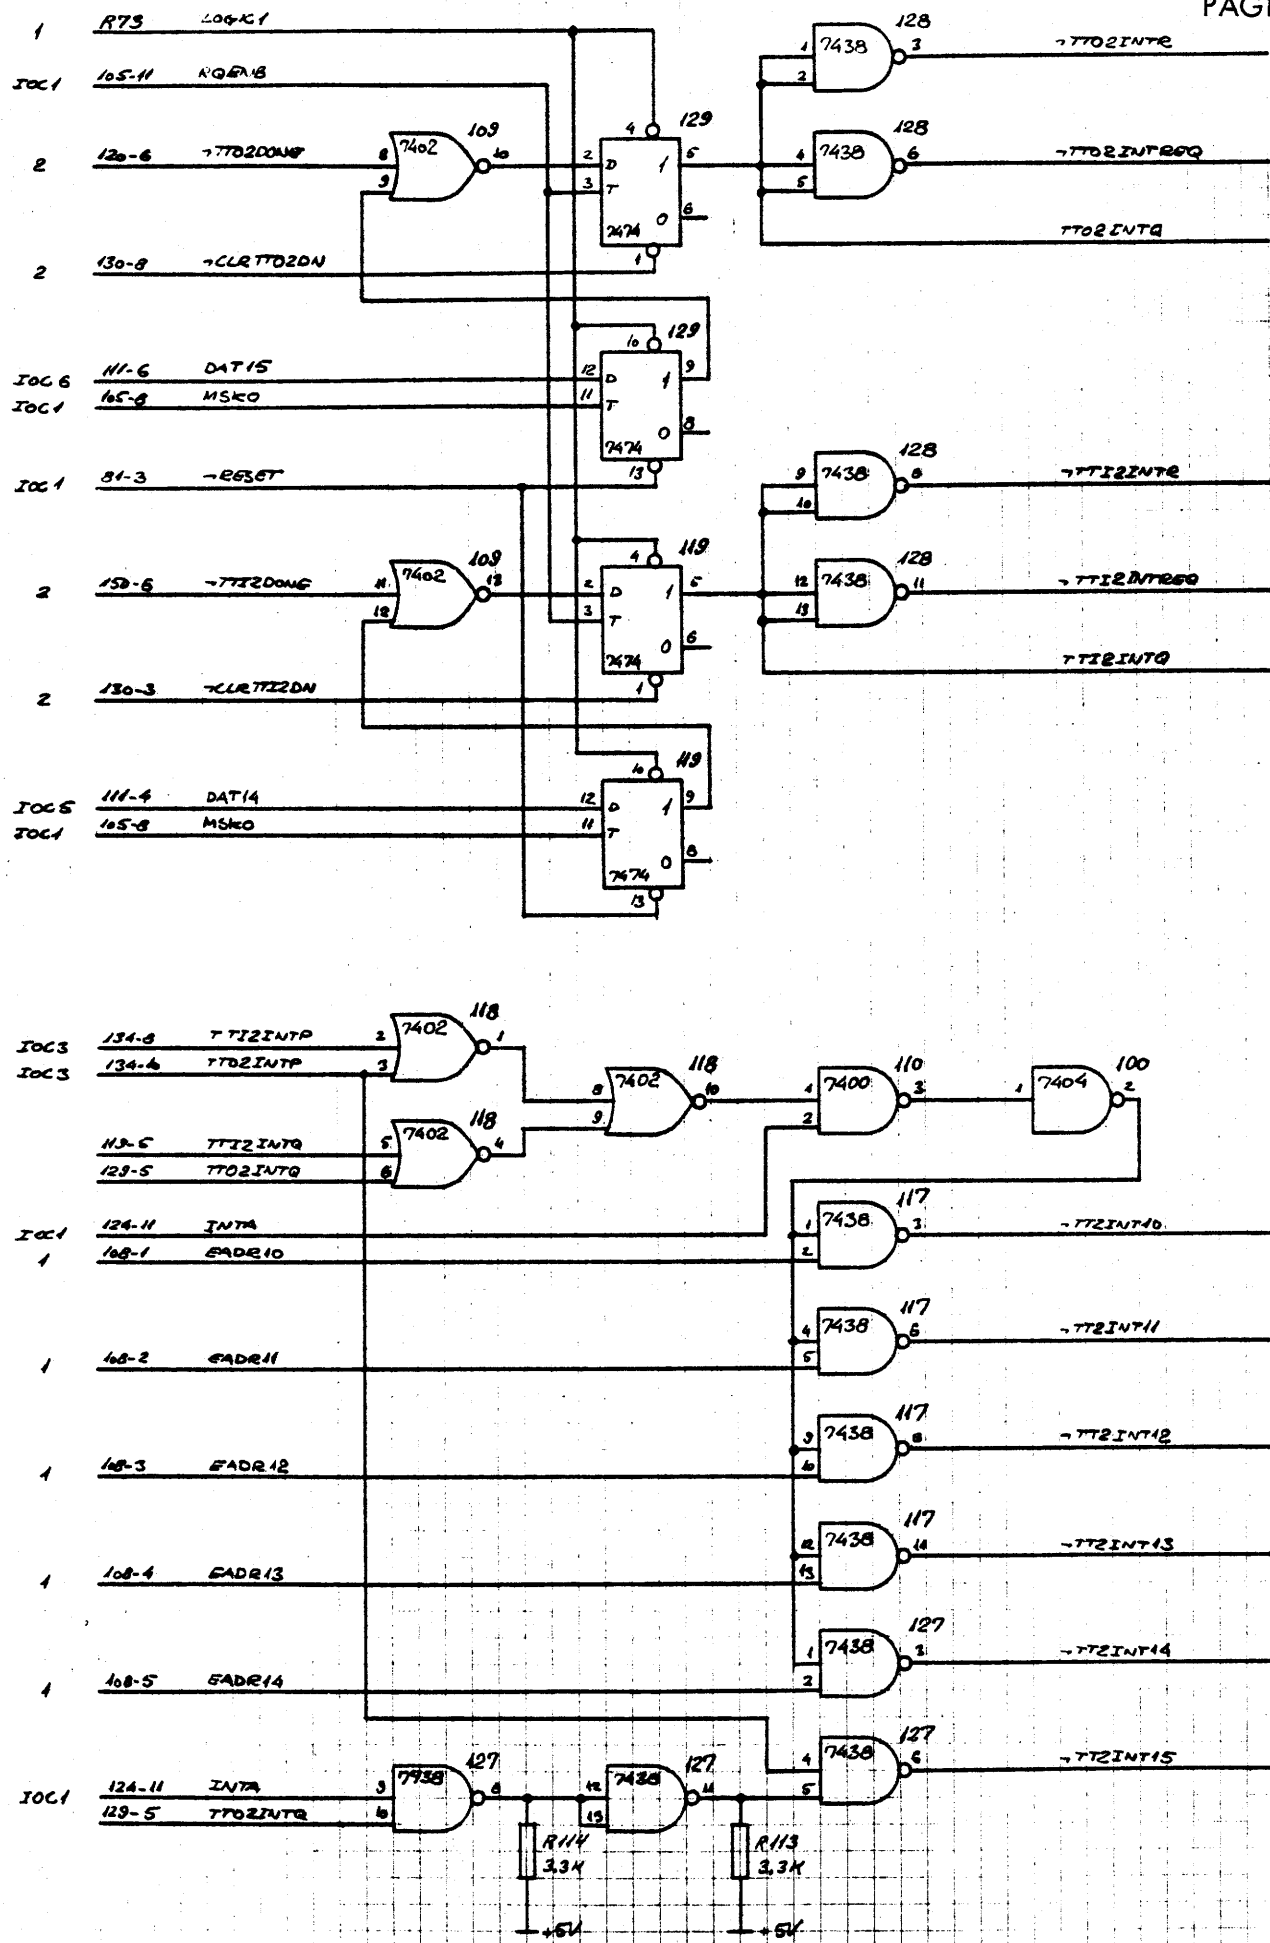

Replaces Dwg. No. R11189  
 due to ECN  
 Design Check  
 Dwg. Office Check  
 Drawn by  
 Designed by 7502.05 JDO  
 A/S REGNENTRALEN  
 Unit T7C711  
 Dwg. No. R12074


Unit	T7C711	INTERRUPT AND INTA LOGIC	T7C
Dwg. No.	R12074	LOGIC DIAGRAM	3

 


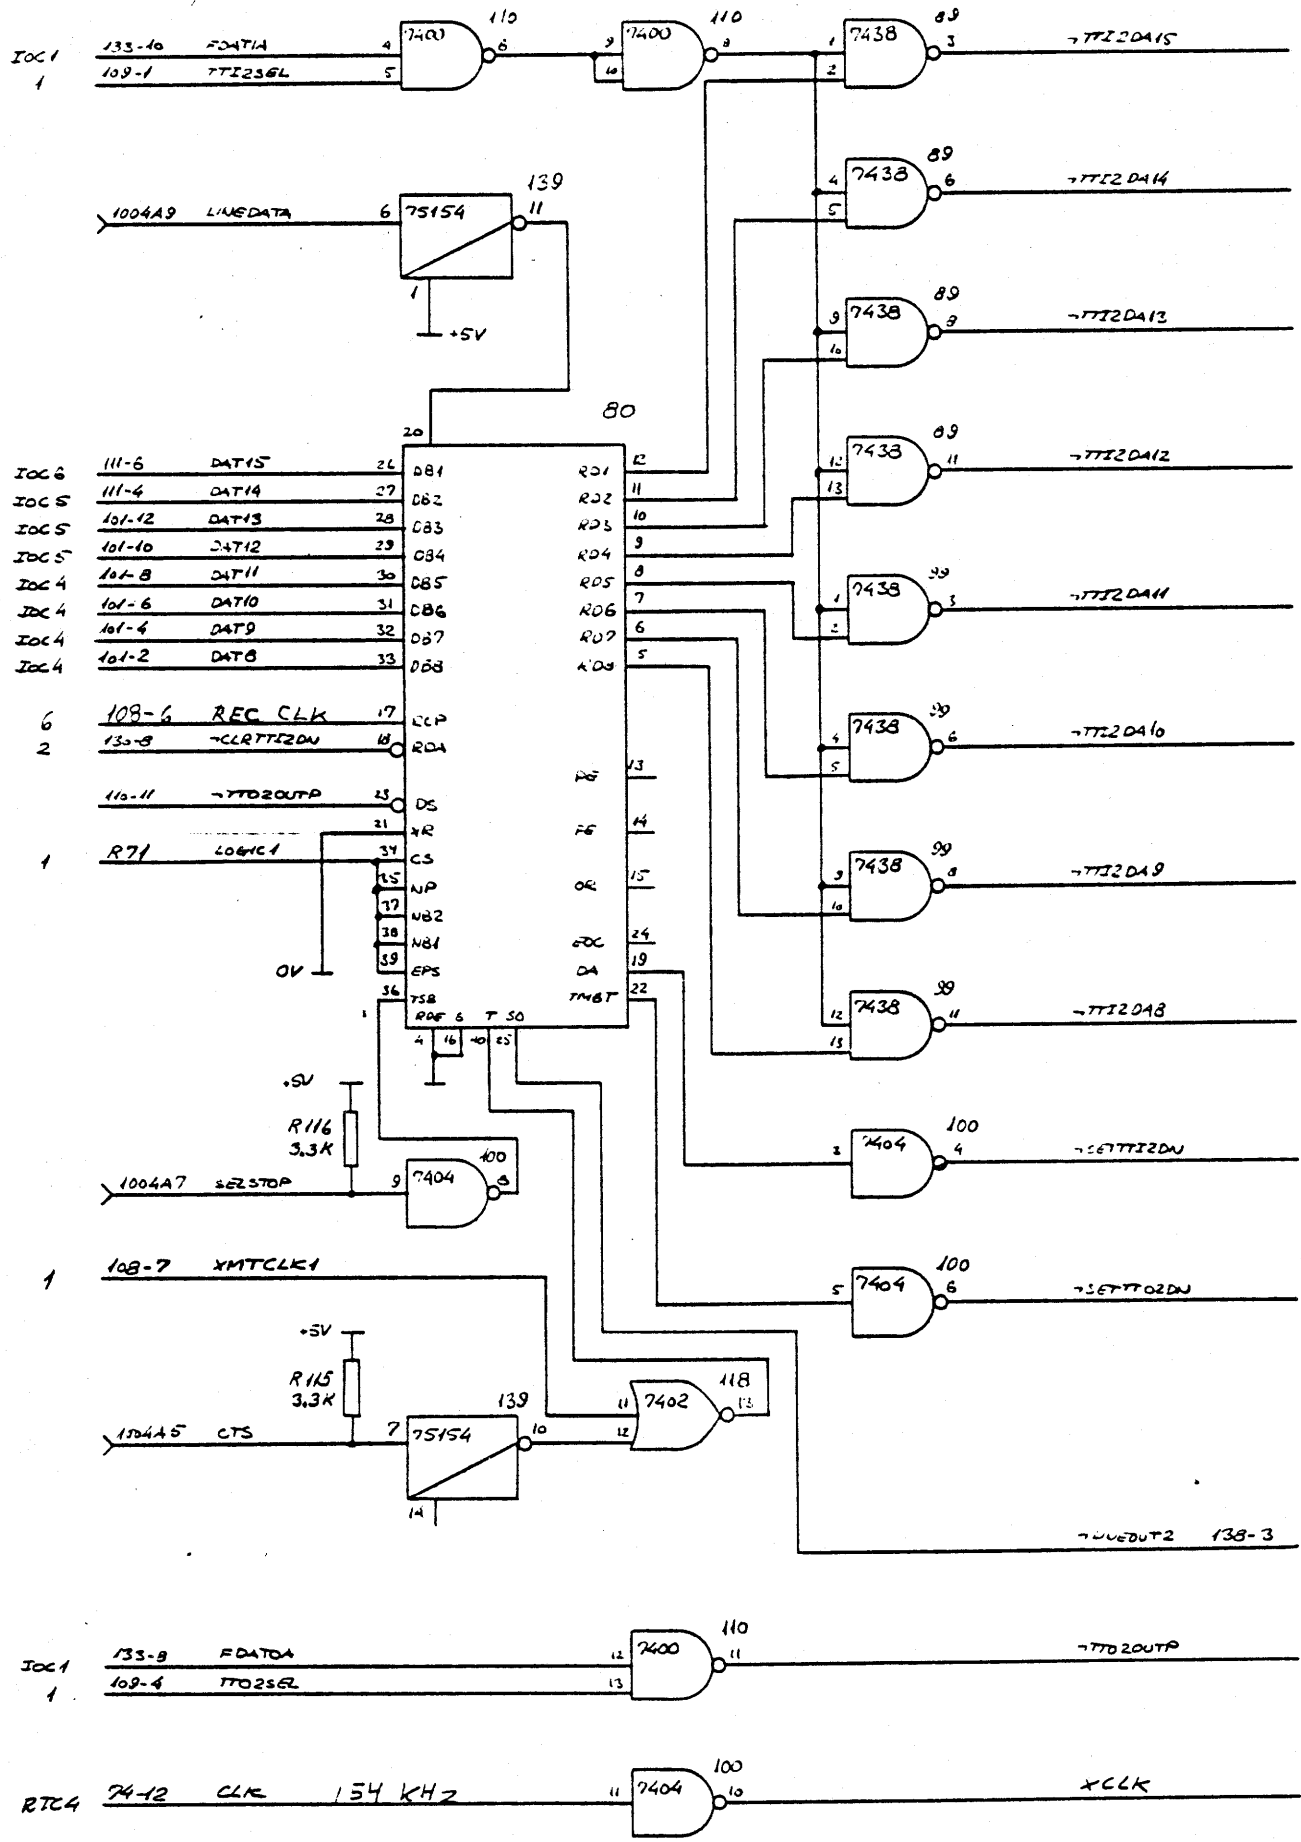

AC doc V8 110  
 AIS REGNENCENTRALEN  
 Designed by 75.02.05 JJO  
 Drawn by  
 Dwg. Office  
 Design Check  
 due to ECN  
 Replaces Dwg. No. R 12075  
 Replaces by Dwg. No.

Unit	T7C711	RECEIVER AND TRANSMITTER LOGIC	T7C 4
Dwg. No.	R 12 653	LOGIC DIAGRAM	

 

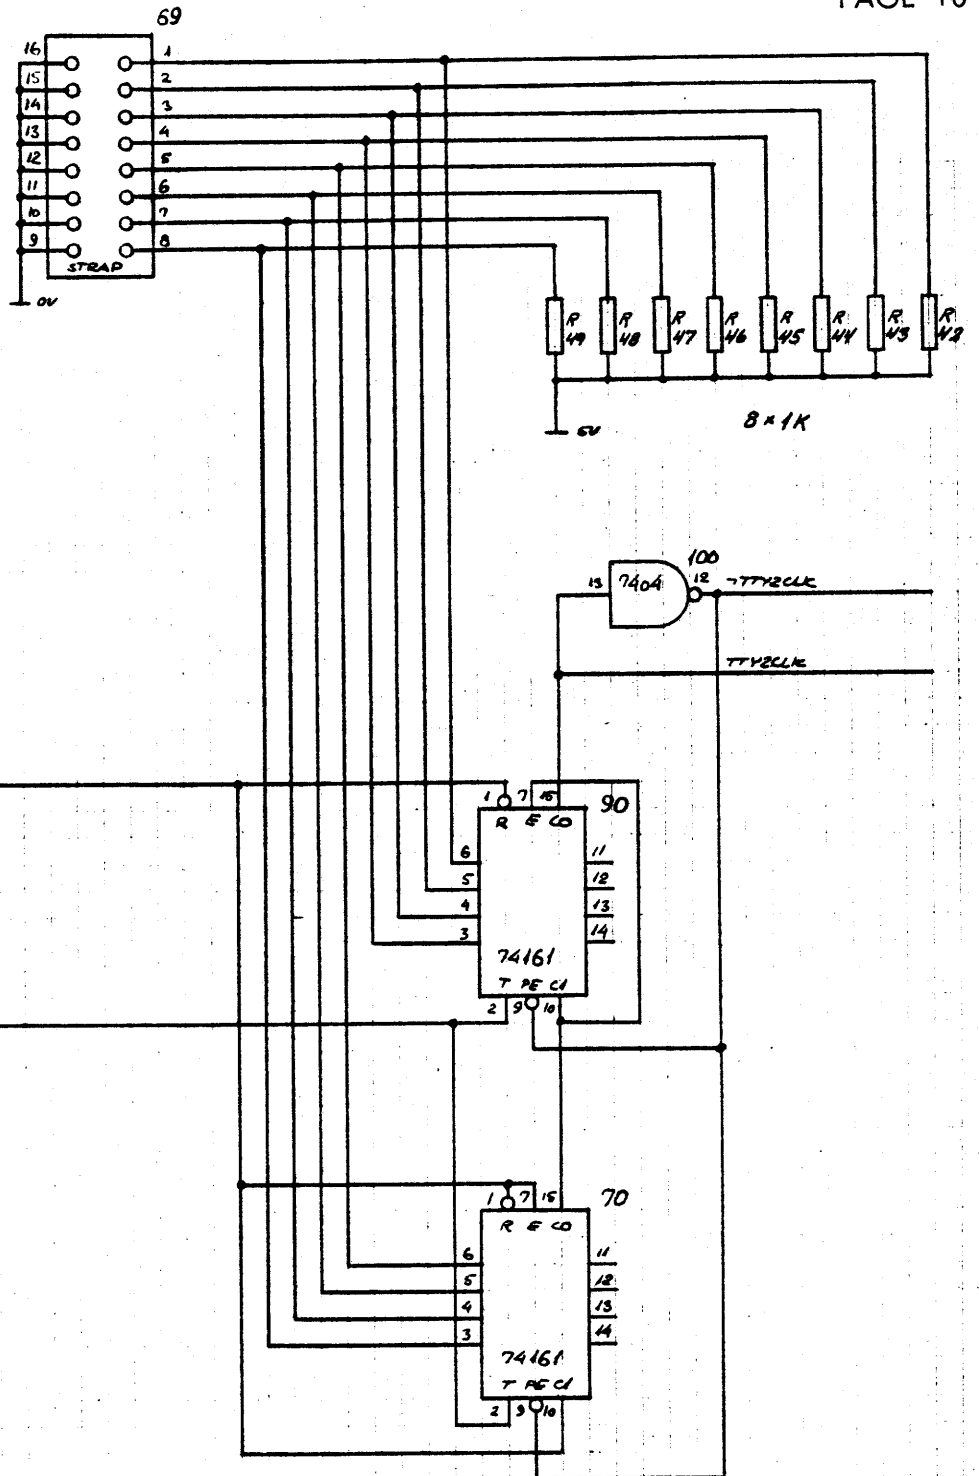

1 R73 LOGIC1

 
4 100-10 XCLK

Replaced by Dwg. No. \_\_\_\_\_  
 due to ECN \_\_\_\_\_  
 Replaces Dwg. No. R 11191  
 Design Check \_\_\_\_\_  
 Dwg. Office Check \_\_\_\_\_  
 Drawn by \_\_\_\_\_  
 Designed by 75.02.05 J30  
**A/S REGNOCENTRALEN**

Unit TTC7H  
 Dwg. No. R12076

CLOCK CIRCUIT  
 LOGIC DIAGRAM

TTC  
 5





IOC707:

RESISTORS:

- R 87 to R 110
- 2% 0,4W Metalfilm
- All other resistors
- 5% 1/8W Carbonresistors

Pos 41 STRAP:

Real Time Clock Device Code

Pos 54 STRAP:

Paper Tape Reader Contr.  
Device Code

Pos 94 STRAP:

First Teletype Contr. Device Code

Pos 96 STRAP:

First Teletype Contr.  
Selection of Speed

PUC703:

Pos 68 STRAP:

Paper Tape Punch Contr.  
Device Code

TIC711:

Pos 108 STRAP:


Second Teletype Contr.  
Device Code

Pos 69 STRAP:

Second Teletype Contr.  
Selection of Speed

All Strappings:


- Strap = logic 0
- No Strap = logic 1

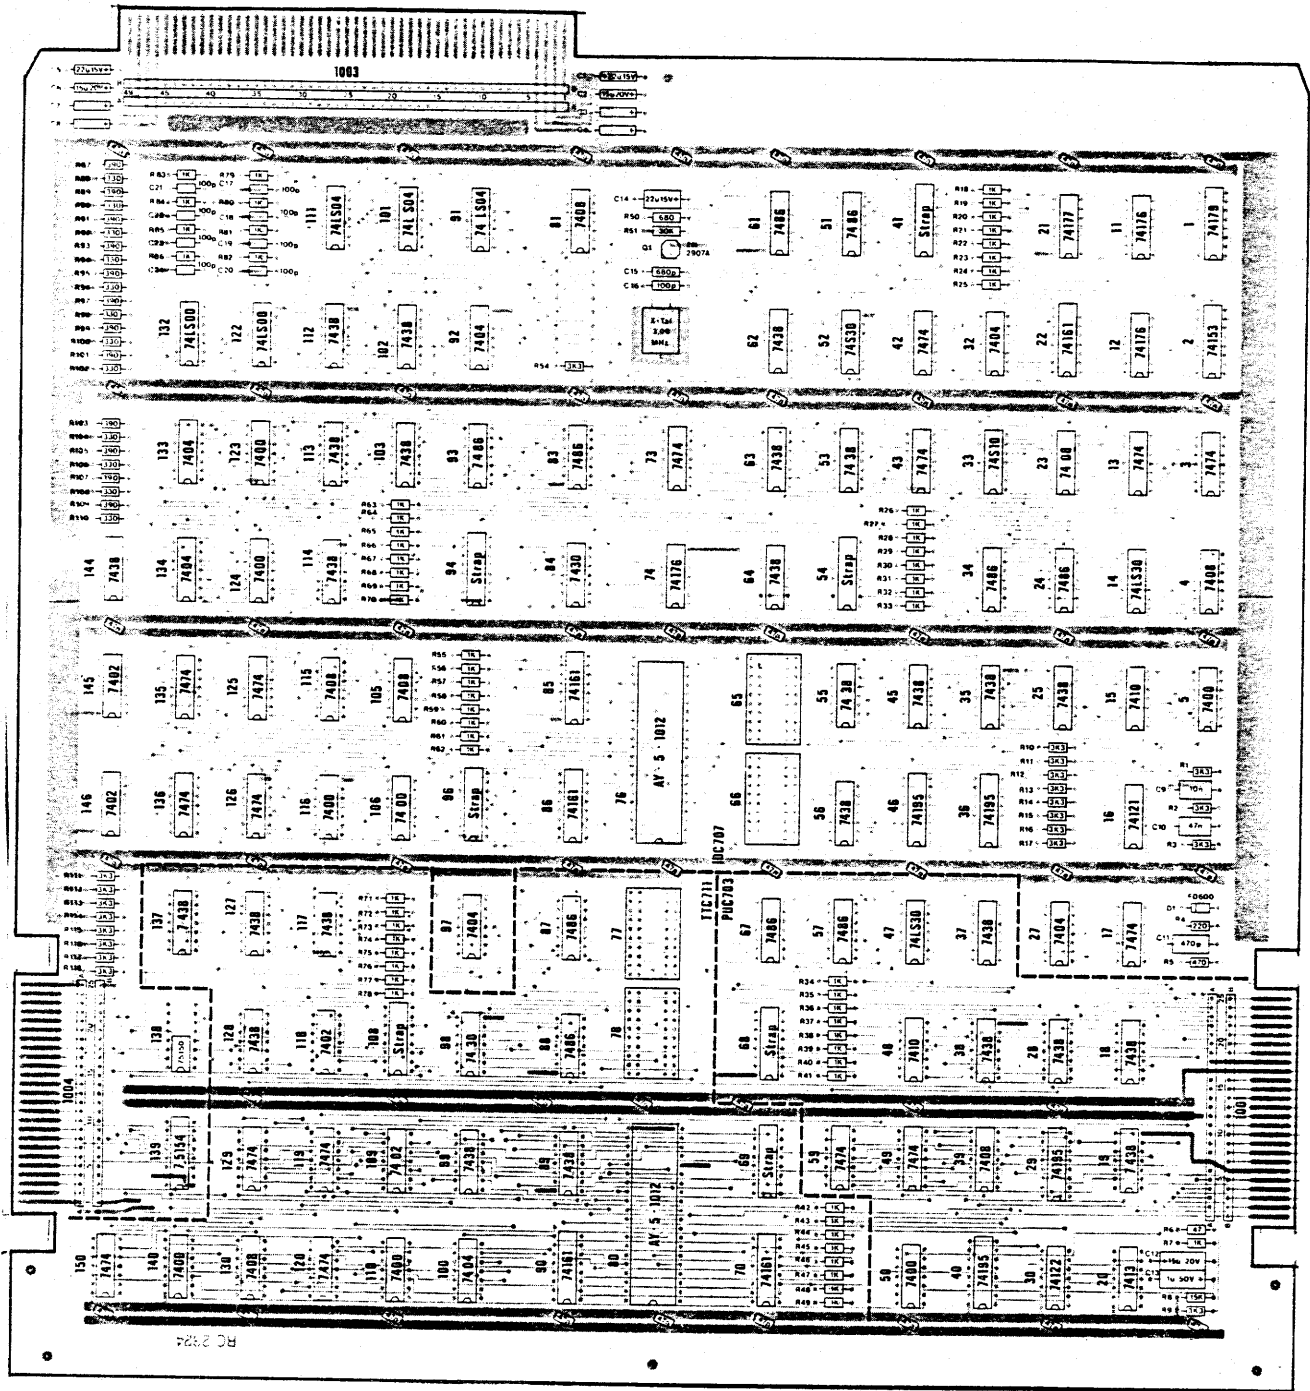





A/S REGNECENTRALEN	Designed by 75.01.02. JJO	Drawn by	Dwg. Office Check	Design Check	Replaces Dwg. No.	due to ECN	Replaced by Dwg. No.
--------------------	------------------------------	----------	-------------------	--------------	-------------------	------------	----------------------

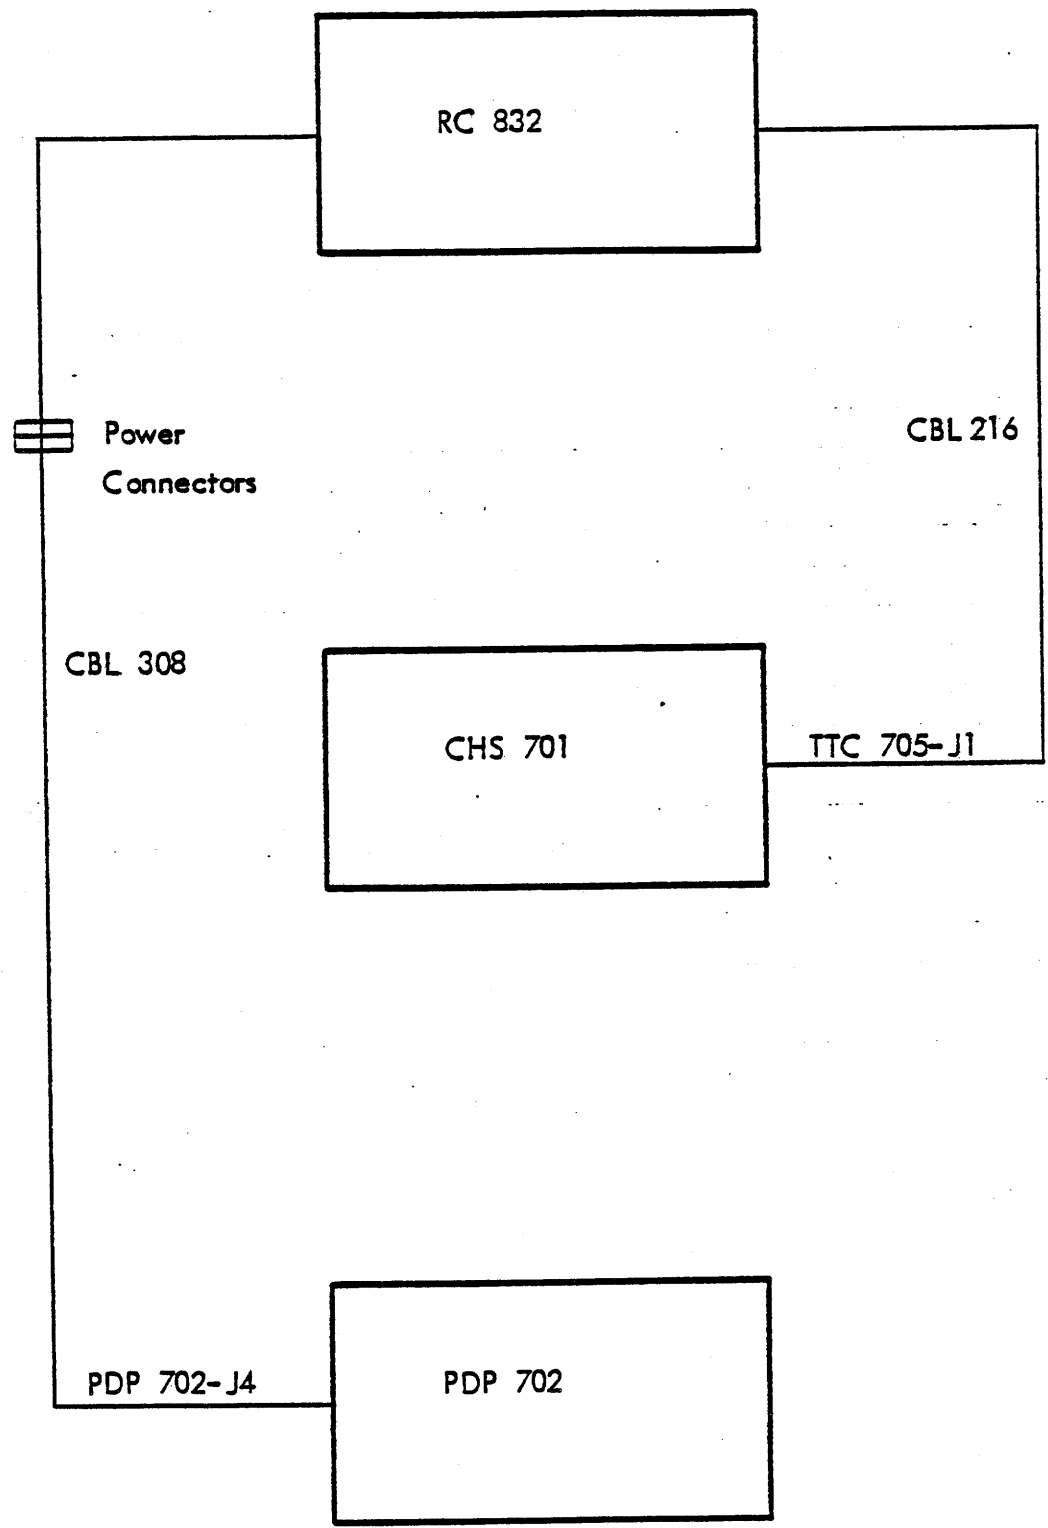


~~44-RT-733-65~~  
 Dwg No  
 R 21143  
 Dwg No

RC 832 Teletype connected to TTC 705 Controller and PDP 702 Power Panel

Interconnection Diagram


RC doc: VB 139	A/S REGNENCENTRALEN	Designed by	760304 JEMI	Drawn by	770114 AOB	Dwg. Office Check	Design Check	Replaces Dwg. No.	due to ECN	Replaced by Dwg. No.
----------------	---------------------	-------------	-------------	----------	------------	-------------------	--------------	-------------------	------------	----------------------

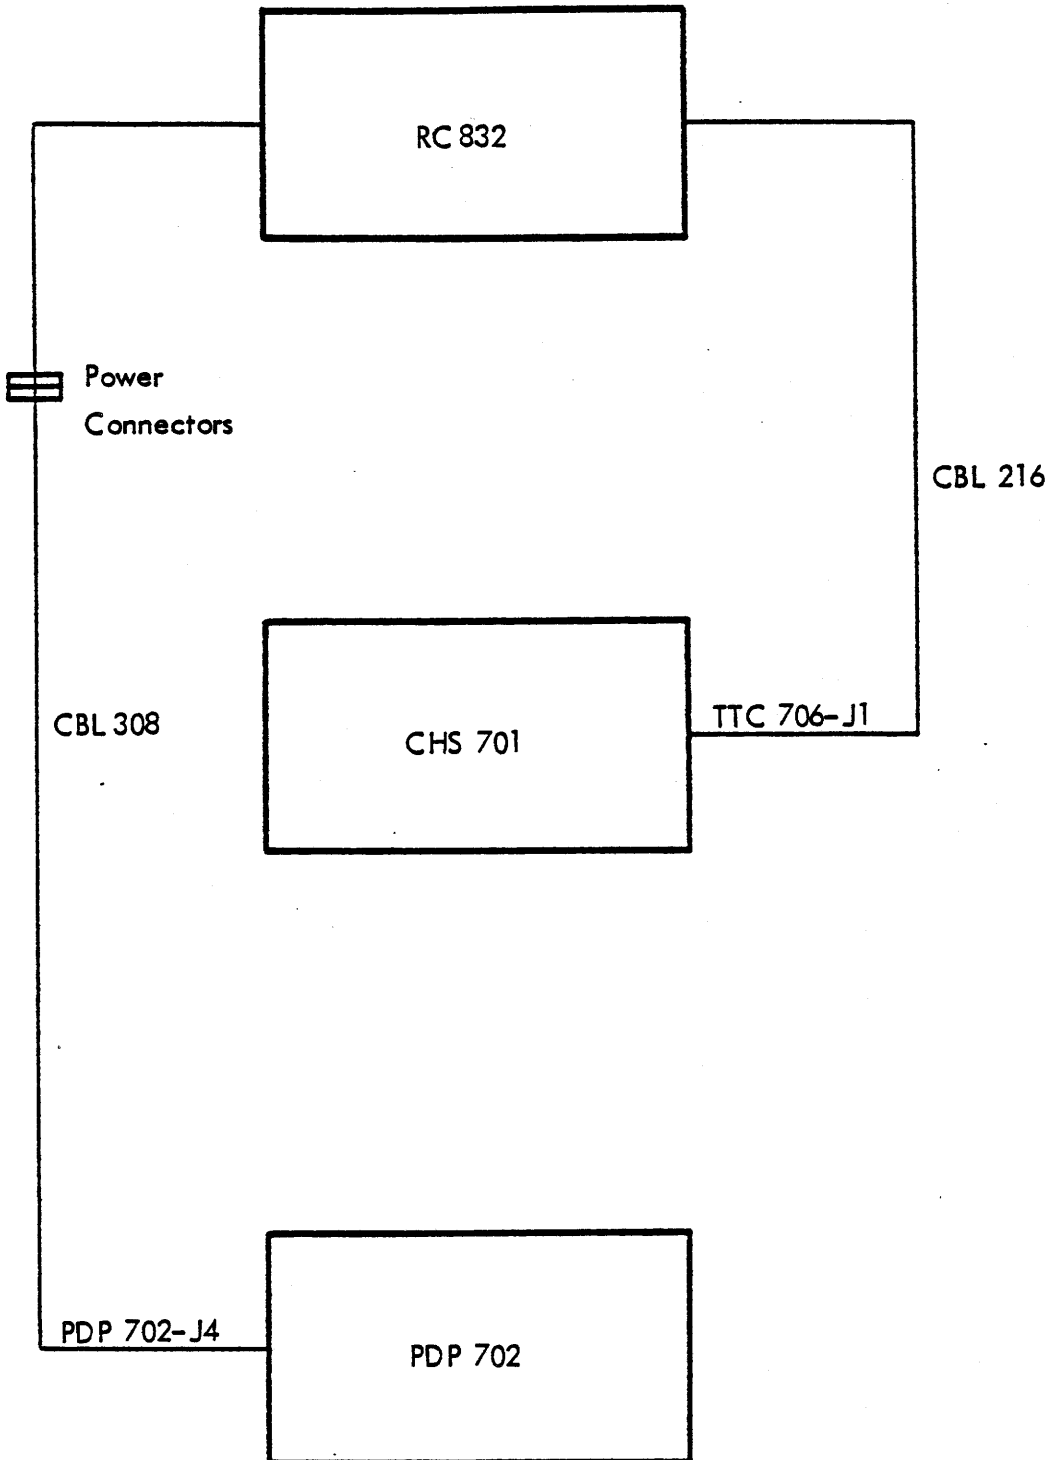

Dwg. No.  
 44-RT-733-76  
 Dwg. No.  
 R21144

Second RC 832 Teletype connected to  
 TTC 706 Controller and PDP 702 Power Panel  
 Interconnection Diagram


A/S REGNECENTRALEN	Designed by	760304 JEMI	Drawn by	770114 AOB	Dwg. Office Check	Design Check	Replaces Dwg. No.	due to ECN	Replaced by Dwg. No.
--------------------	-------------	-------------	----------	------------	-------------------	--------------	-------------------	------------	----------------------

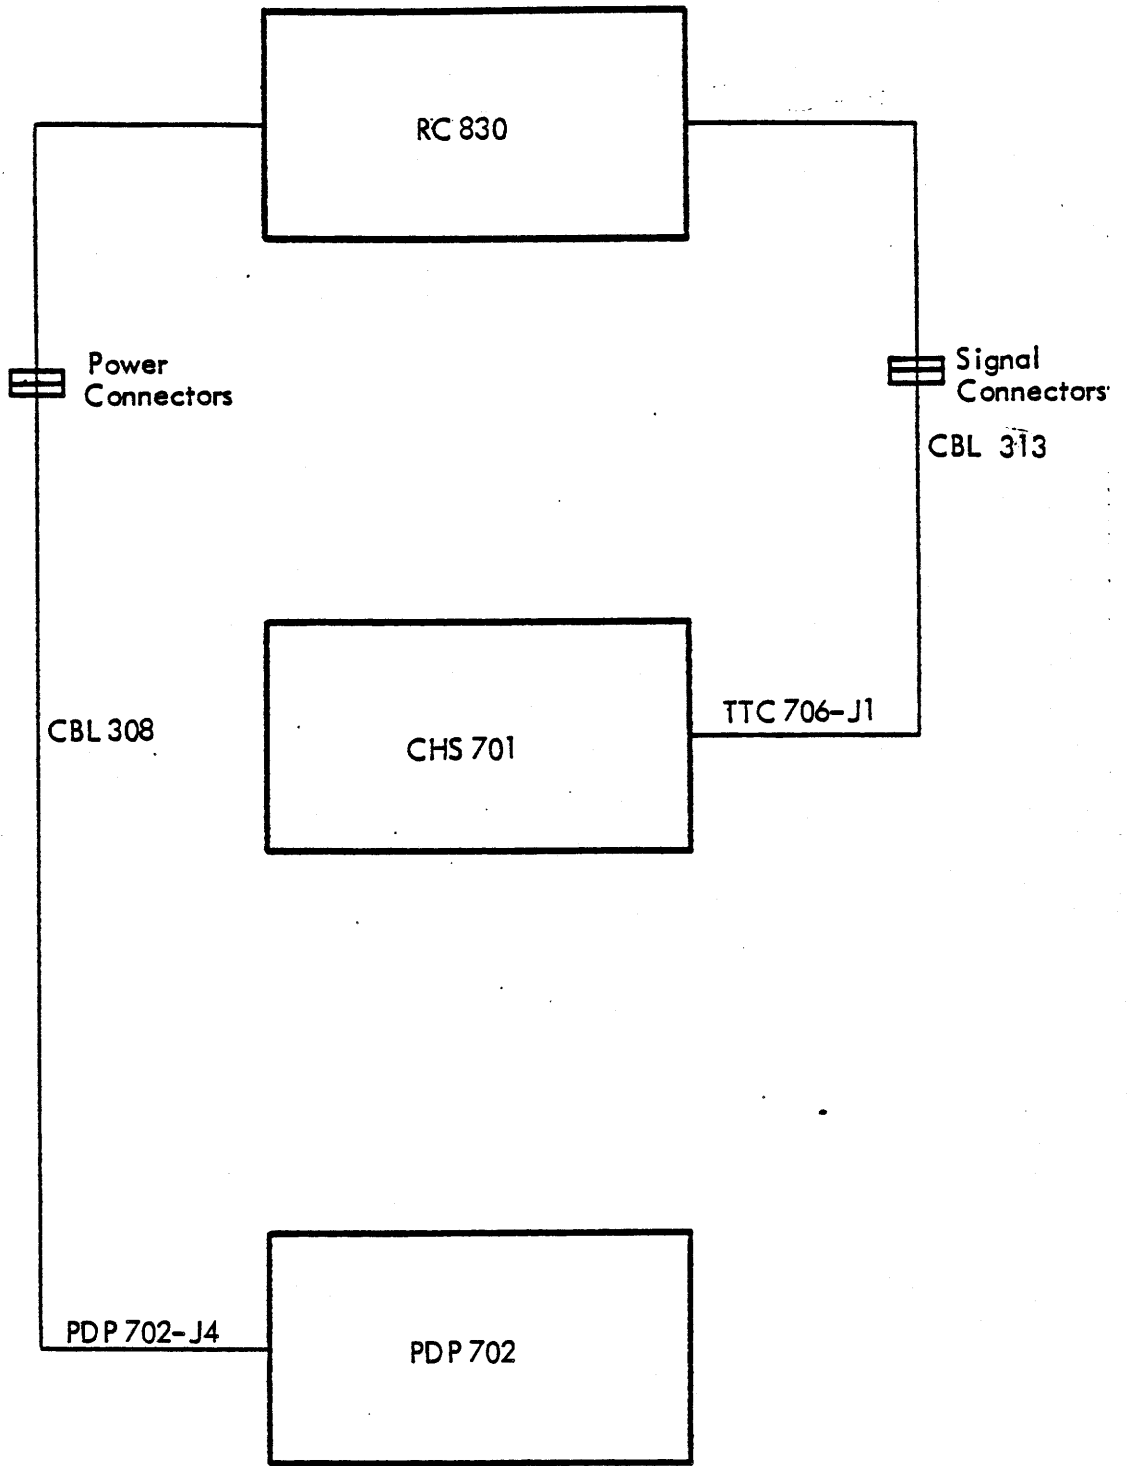

Unit Dwg. R21145  
 Dwg. No. 44-RT 733-81

RC 830 Second Silent connected to  
 TTC 706 Controller and PDP 702 Power Panel  
 Interconnection Diagram


RC doc. VB 139	A/S REGNECENTRALEN	Designed by	760304 JEMI
		Drawn by	770114 AOB
		Dwg. Office Check	
		Design Check	
		Replaces Dwg. No.	
		due to ECN	
		Replaced by Dwg. No.	

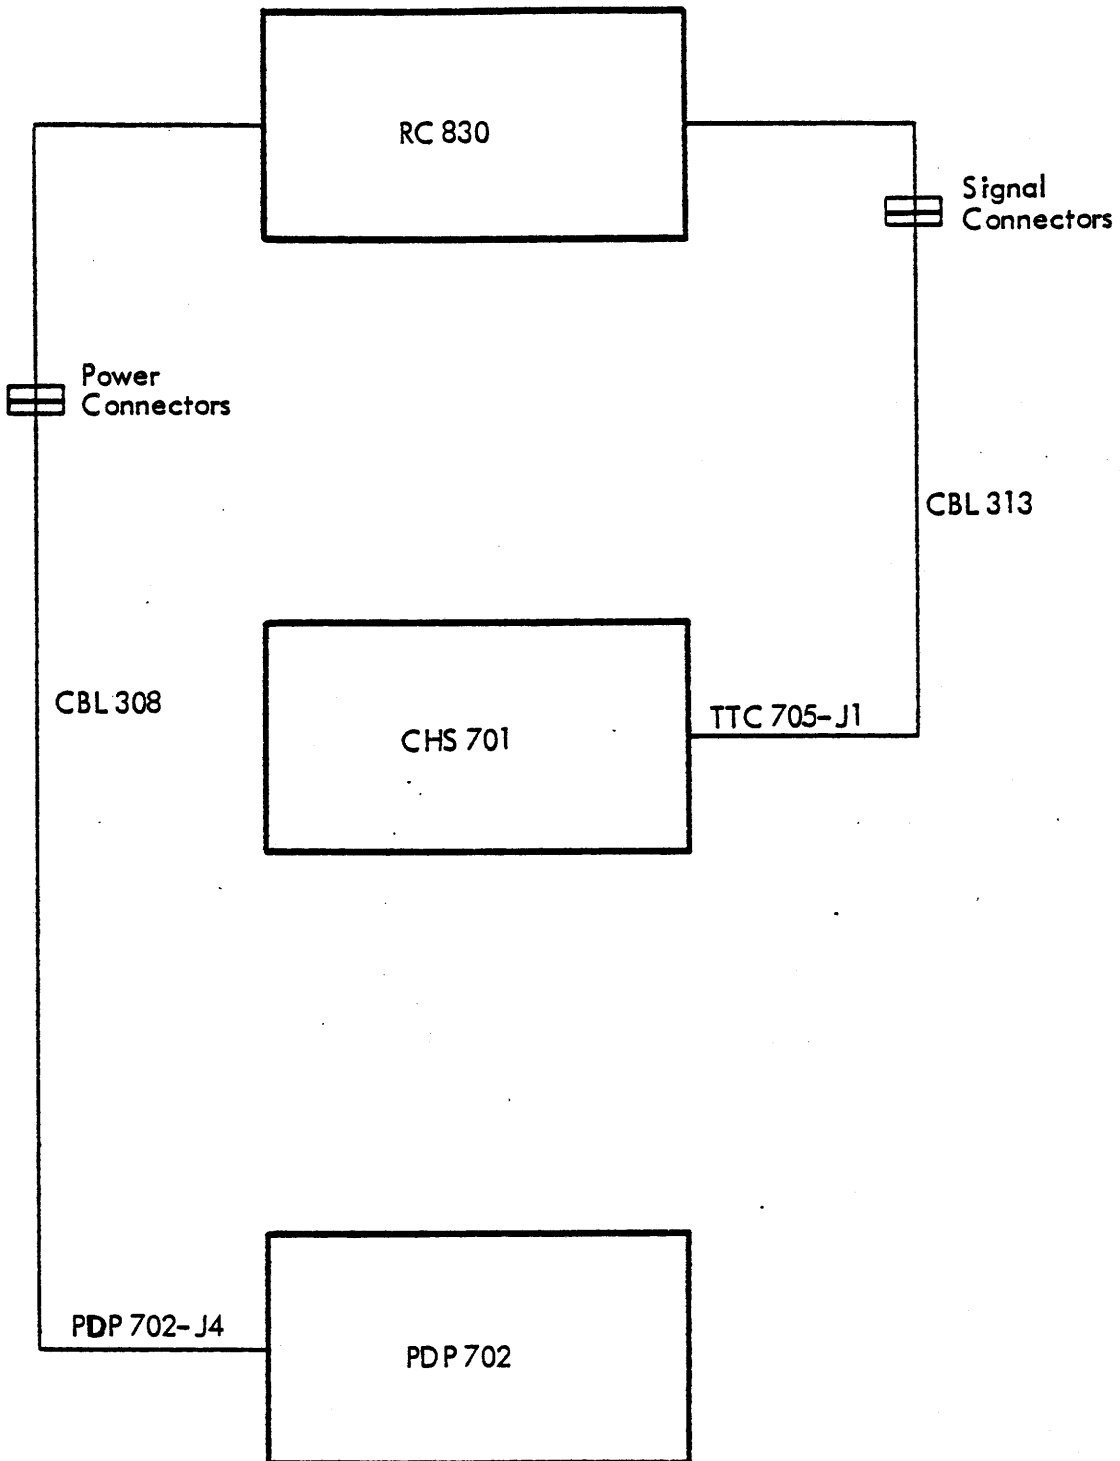

Unit DWG  
R21146  
Dwg. No.  
44 RT 733-82

RC 830 Silent connected to TTC 705  
Controller and PDP 702 Power Panel  
Interconnection Diagram

A/S REGNENCENTRALEN	Designed by	760304 JEMI
	Drawn by	770114 AOB
	Dwg. Office Check	
	Design Check	
	Replaces Dwg. No.	
	due to ECN	
Replaced by Dwg. No.		

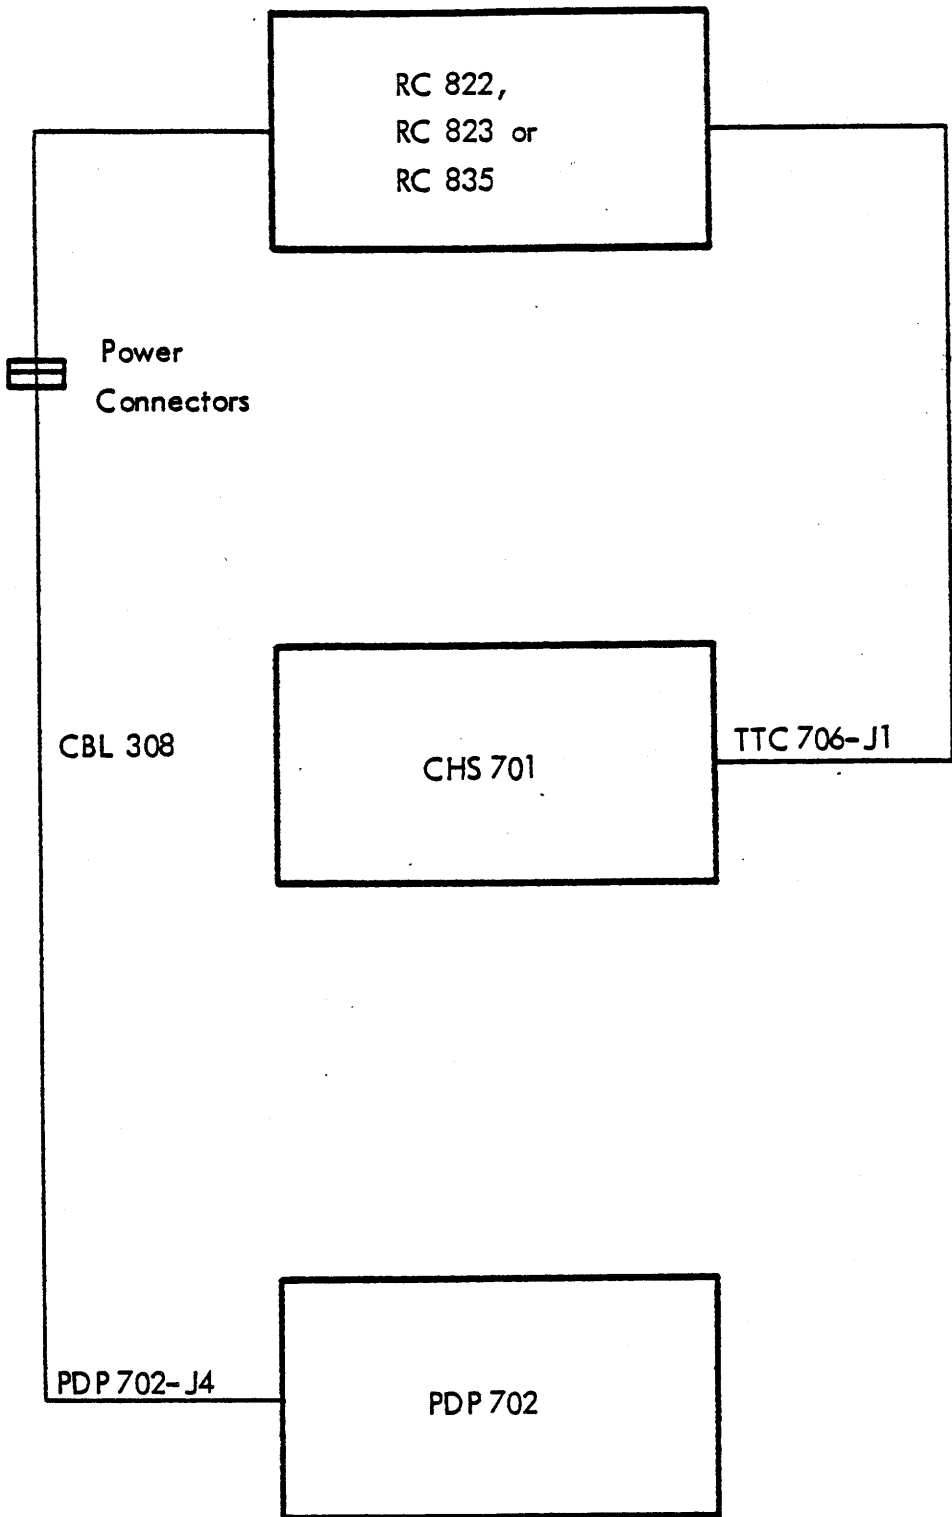


Unit *DW9*  
*R21147*  
 Dwg. No. ~~44-RT-733-85~~  
 RC 822, RC 823 or RC 835 Second Console connected to  
 TTC.706. Controller and PDP 702 Power Panel  
 Interconnection Diagram

RC doc. VB 139



Replaced by Dwg. No.	
due to ECN	
Replaces Dwg. No.	
Design Check	
Dwg. Office Check	
Drawn by	770114 AOB
Designed by	760304 JEMI

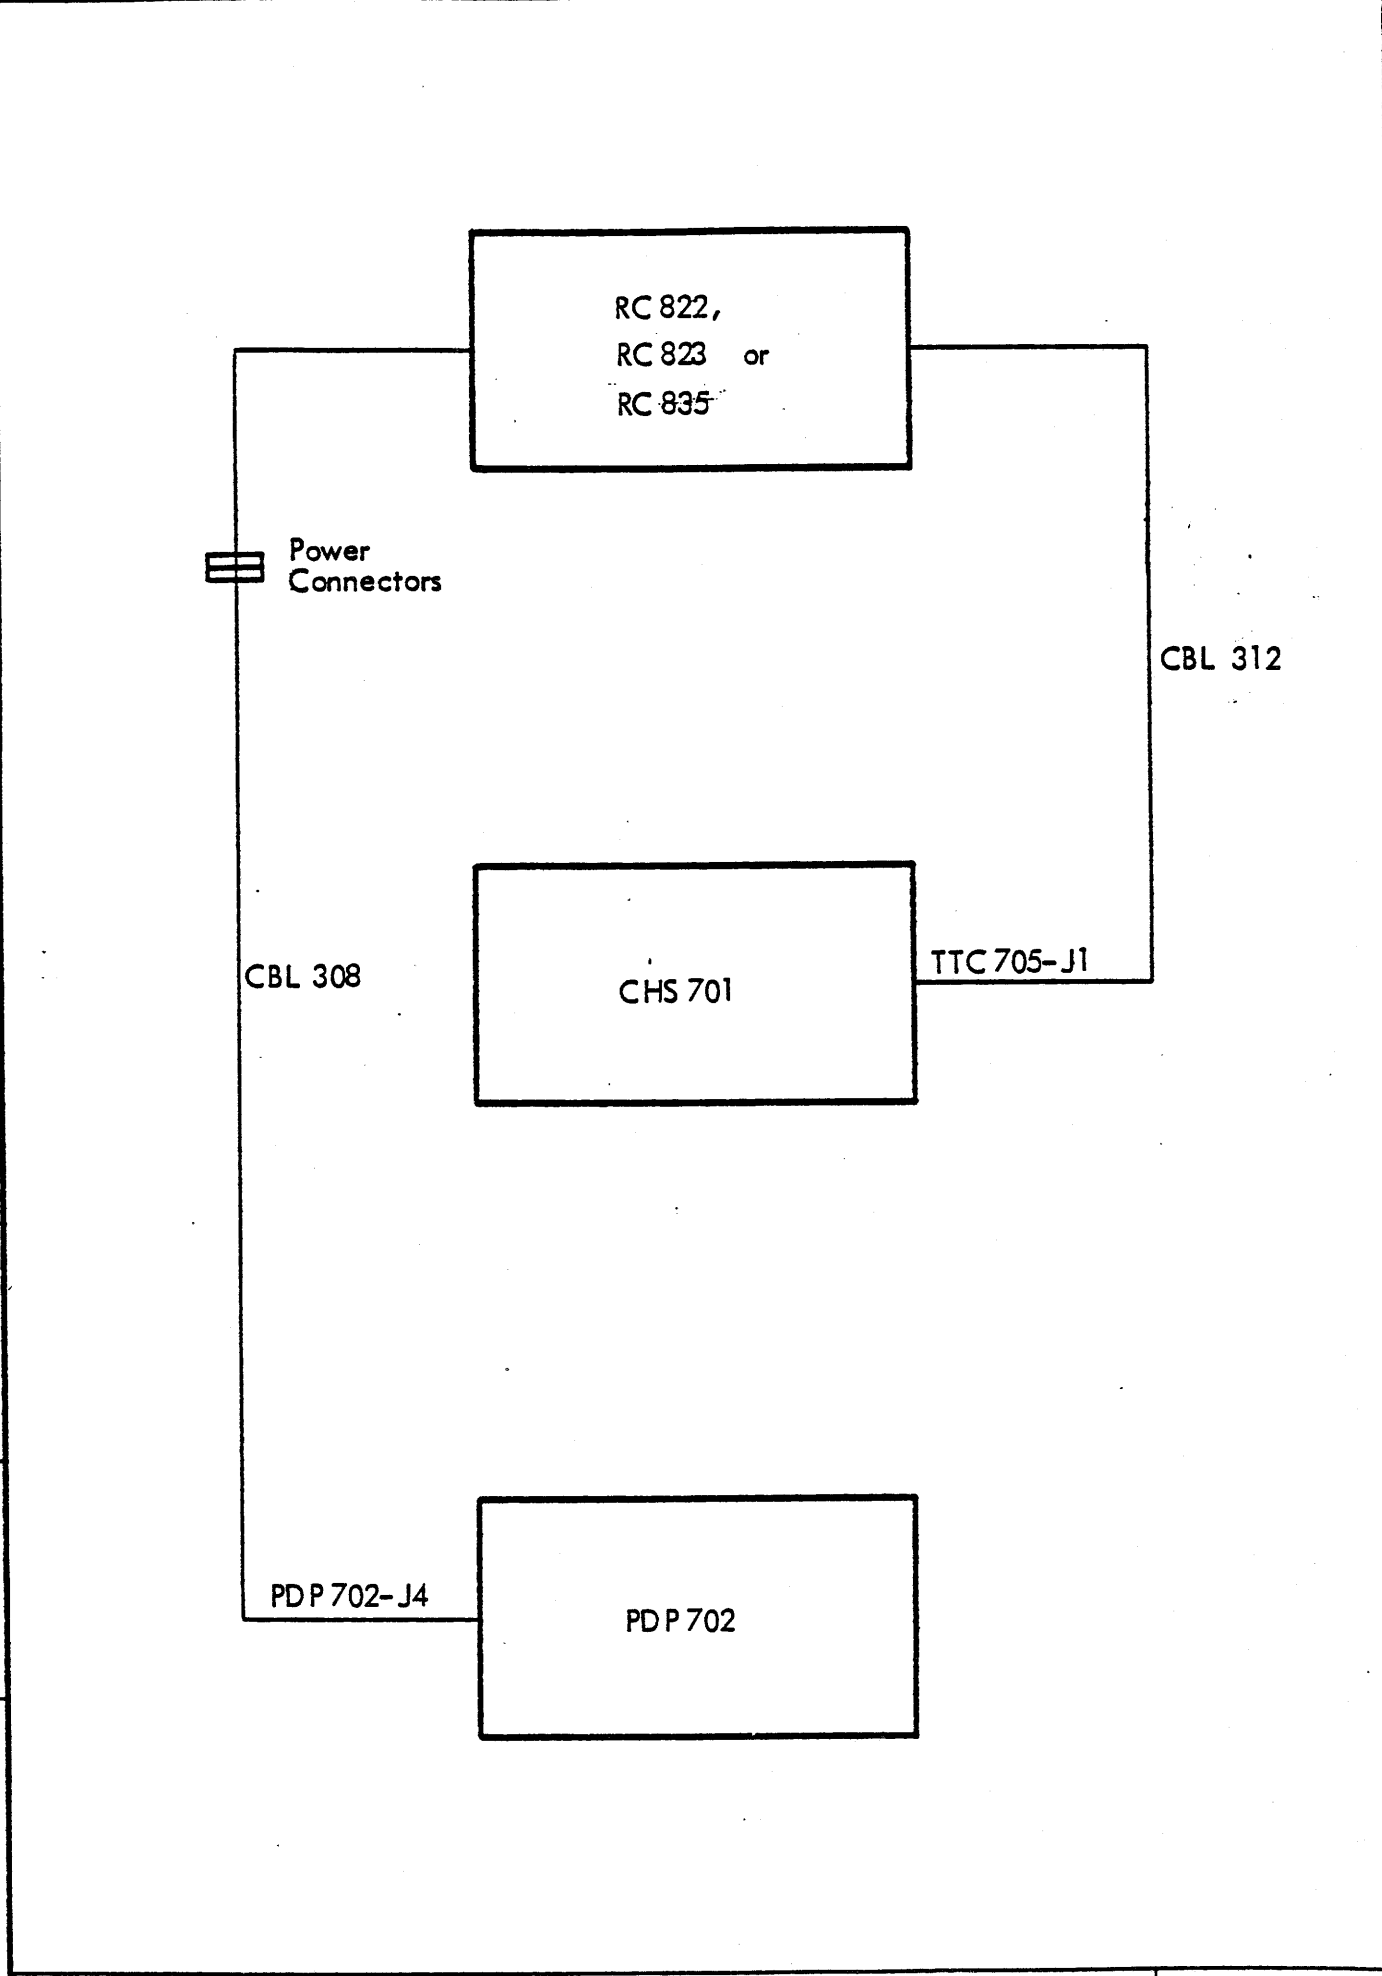


C. doc. VB 139

*Unit DWG*  
**R 21142**  
 Dwg. No.  
~~44-RT 733-86~~

RC 822, RC 823 or RC 835 Console connected to  
 TTC 705 Controller and PDP 702 Power Panel  
 Interconnection Diagram


A/S REGNECENTRALEN

A/S REGNOCENTRALEN	Designed by	770118 JEMI	Dwg. Office Check	Design Check	Replaces Dwg. No.	due to ECN	Replaced by Dwg. No.
	Drawn by	770118 AOB					

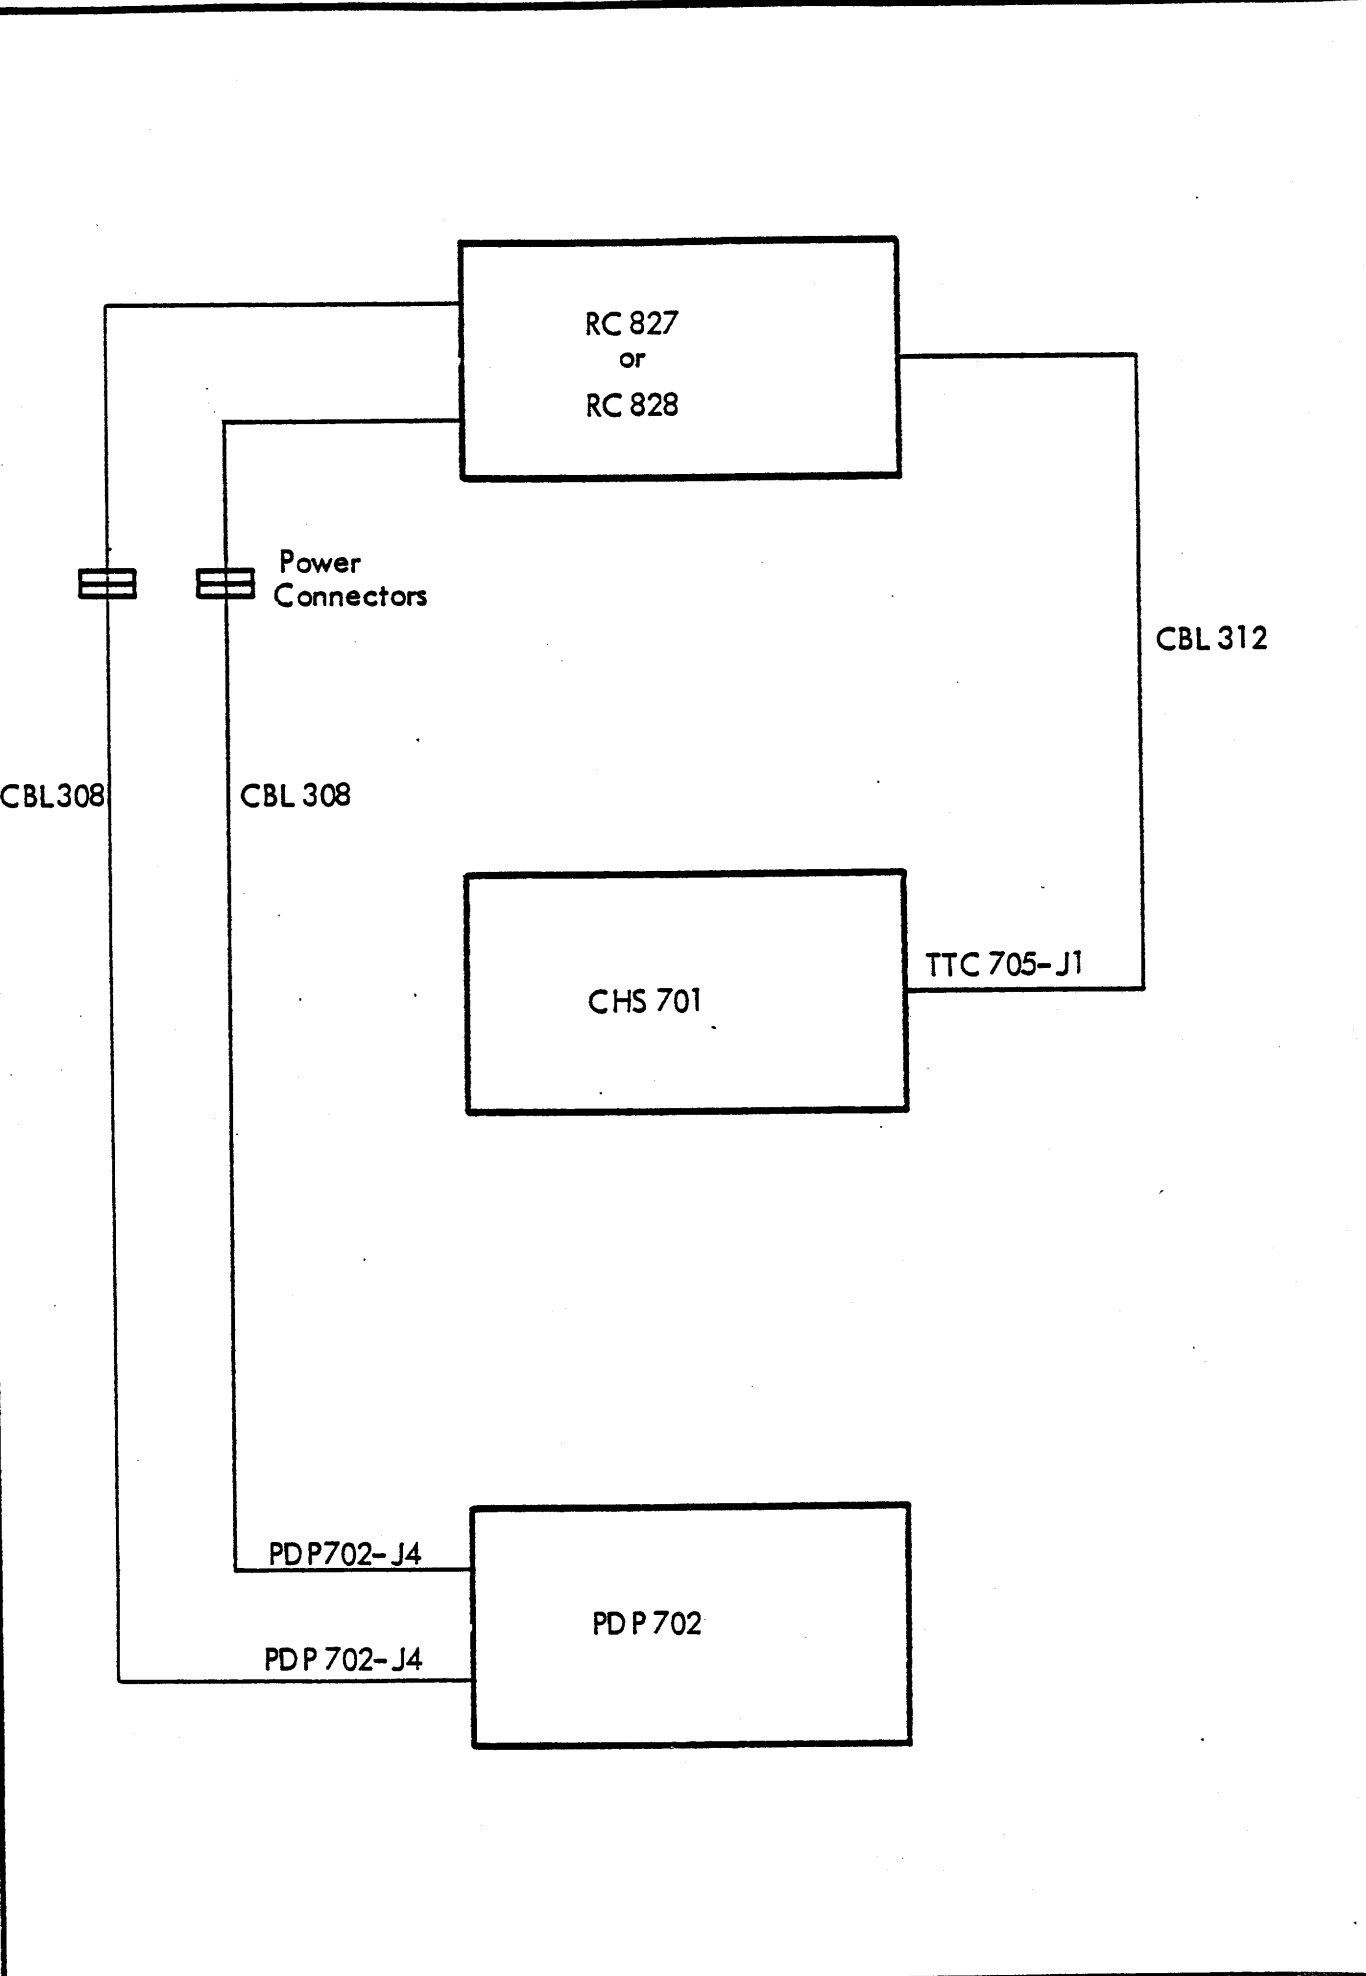

DWG <b>R 21149</b> Dwg. No. <del>44 RT 733 90</del>	RC.827. or. RC.828. Data Entry Console connected to TTC 705 Controller and PDP 702 Power Panel Interconnection Diagram	Page 1 of 1
	RC doc: VB 139	

A/S REGNENTRALEN	Designed by	770118 JEMI	Dwg. Office Check	Design Check	Replaces Dwg. No.	due to ECN	Replaced by Dwg. No.
	Drawn by	770118 AOB					

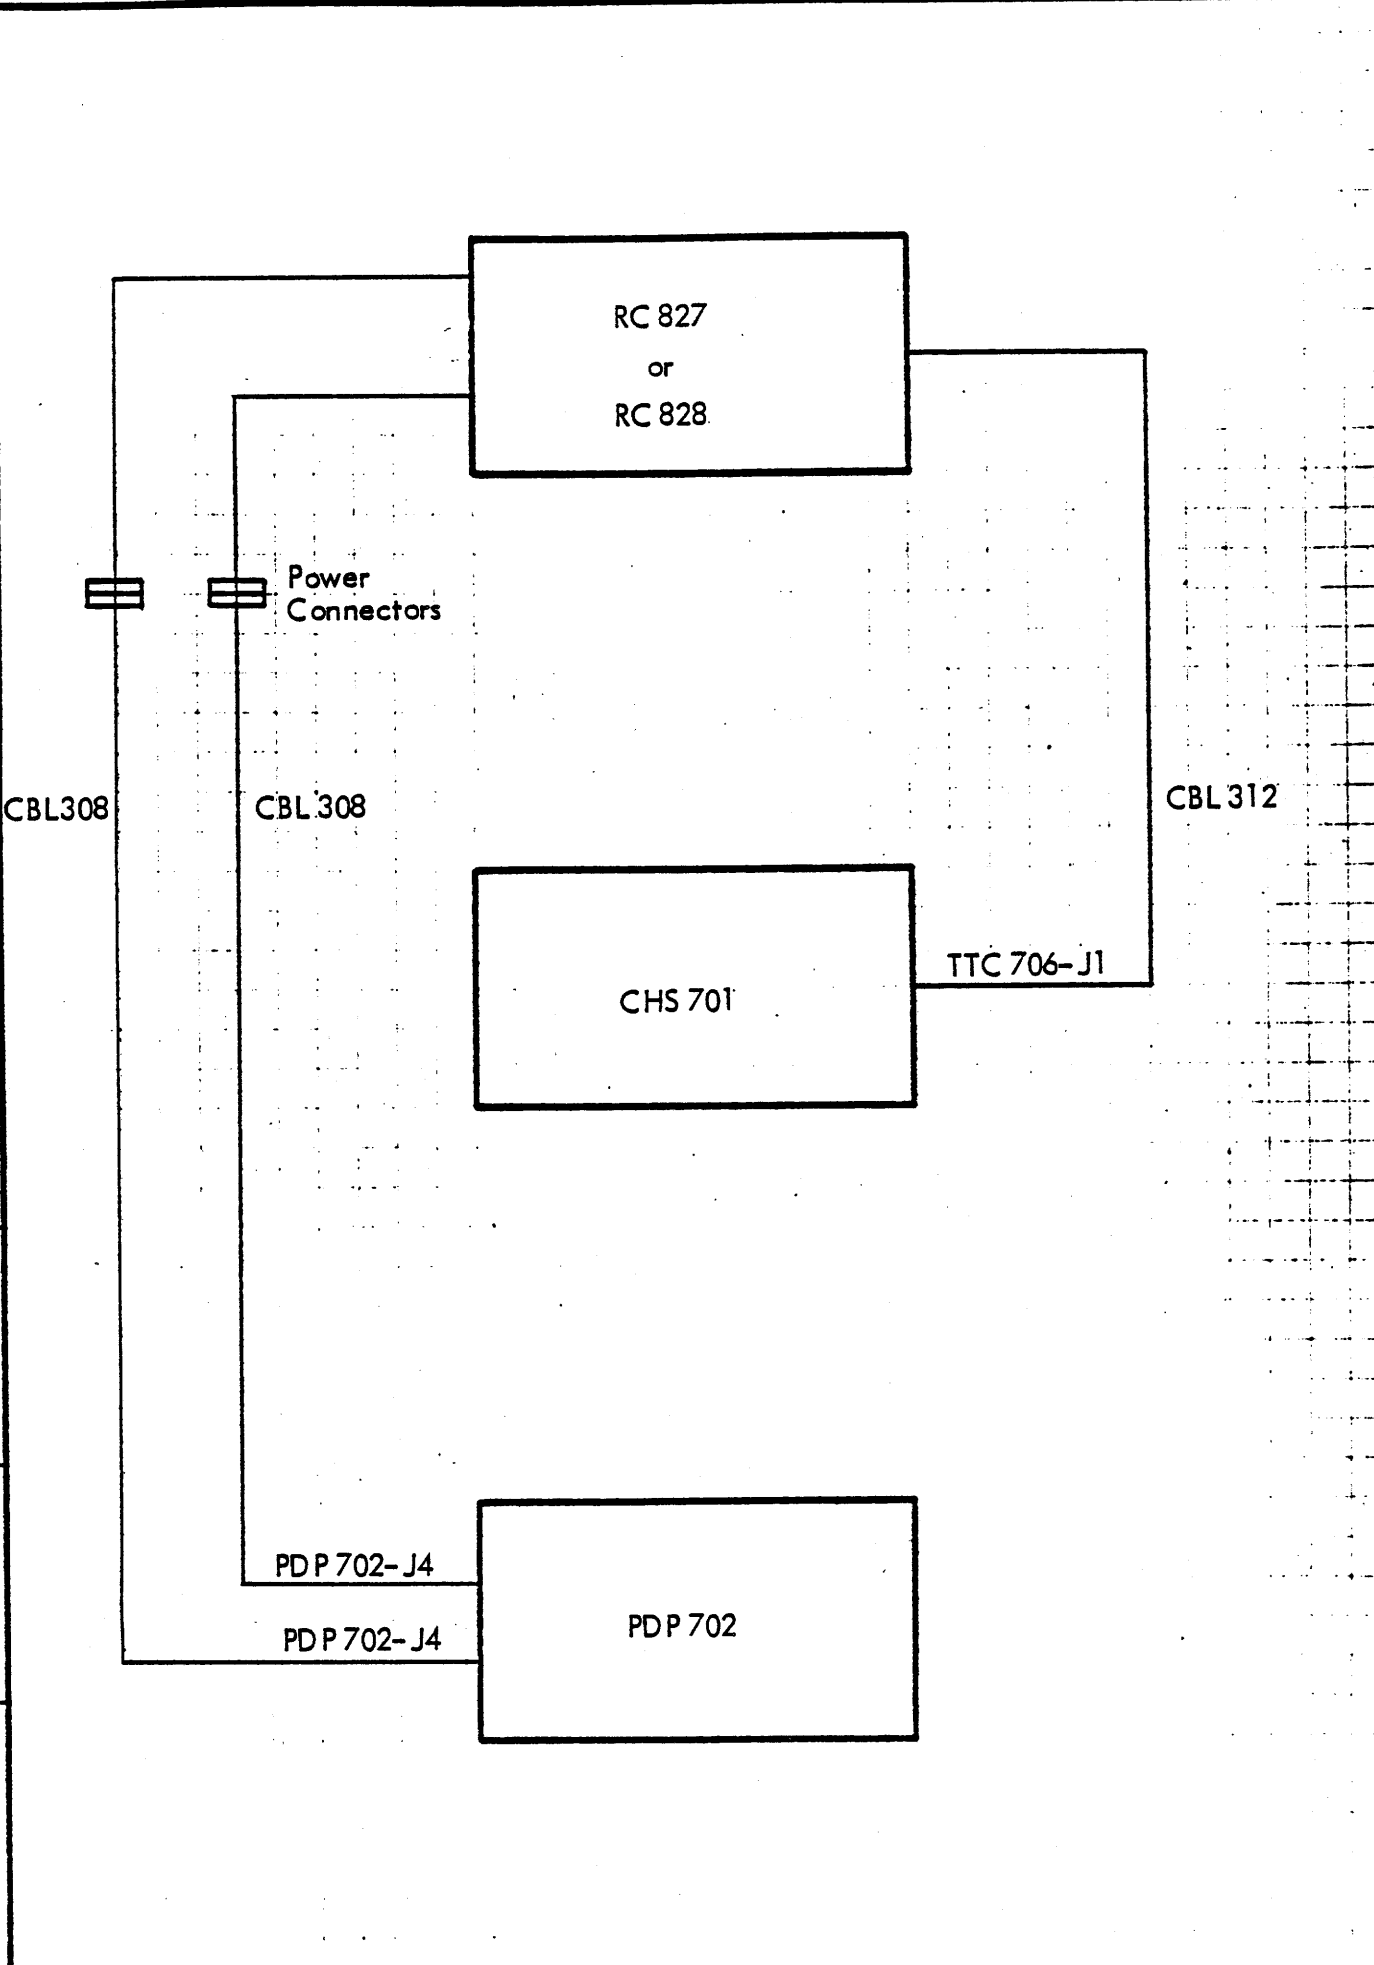

Unit <i>DWG</i> <i>R 21150</i>	RC 827 or RC 828 Second Data Entry Console connected to TTC 706 Controller and	
Dwg. No. <del>44-RT-733-91</del>	PDP 702 Power Panel	
Interconnection Diagram		Page 1 of 1

RC doc: VB 139

HKJ

# FIELD CHANGE ORDER

NO: 12-022  
ISSUE WEEK 43-78

RCSL: 44 - RT 1634

MANDATORY	<input checked="" type="checkbox"/>	RETROFIT ON FAILURE	<input type="checkbox"/>
WARRANTY	<input checked="" type="checkbox"/>	NON WARRANTY	<input type="checkbox"/>

PAGE 1	OF 3
RE: ECN NO: 12-022	

SERIAL EFFECTIVITY TTC711/335 and upwards	EQUIPMENT AFFECTED RC3600/6000 TTC706/711 Controller for 2nd Tele Type
NOTE	

REASON FOR CHANGE

On the TTC711 the position (80-18) was erroneously connected to (130-8) instead of (130-3), and on TTC706 (80-18) was connected to (120-1) instead of (119-1). This error has the effect that input from second tele type does not function unless the characters are echoed.

DESCRIPTION OF CHANGE

TTC711:

- Cut the connection (80-18) → (129-1) (See page 2)
- Insert a connection (130-3) → (80-18) (See page 3)
- Code the FCO-label 12-022

TTC706:

- Remove the wire (80-18) → (120-1)
- Insert a wire (119-1) → (80-18)
- Code the FCO-label 12-022

ADDITIONAL COMMENTS

QTY:	PARTS REQUIRED	RC -P/N
15 cm	Wire	4-4910

DOCUMENTATION ENCLOSED

Provisional logic diagram for TTC711 (1 page)

Provisional logic diagram for TTC706 (1 page)

KITS FREE OF CHARGE FROM ISS: YES  NO


RETURN CHANGED PARTS TO ISS: YES  NO

ESTIMATED INSTALLATION TIME: 15 minutes

PROJECT ENGINEER		DEVELOPMENT MANAGER		SYS. PRODUCTION MANAGER		TECH. SERVICE MANAGER	
SIGN.	DATE	SIGN.	DATE	SIGN.	DATE	SIGN.	DATE
<i>Walter Friis</i>	10/10-78	<i>Bjc</i>	17/10-78	<i>Godal</i>	18/10-78	<i>W. S. ...</i>	19/10-78



# FIELD CHANGE ORDER

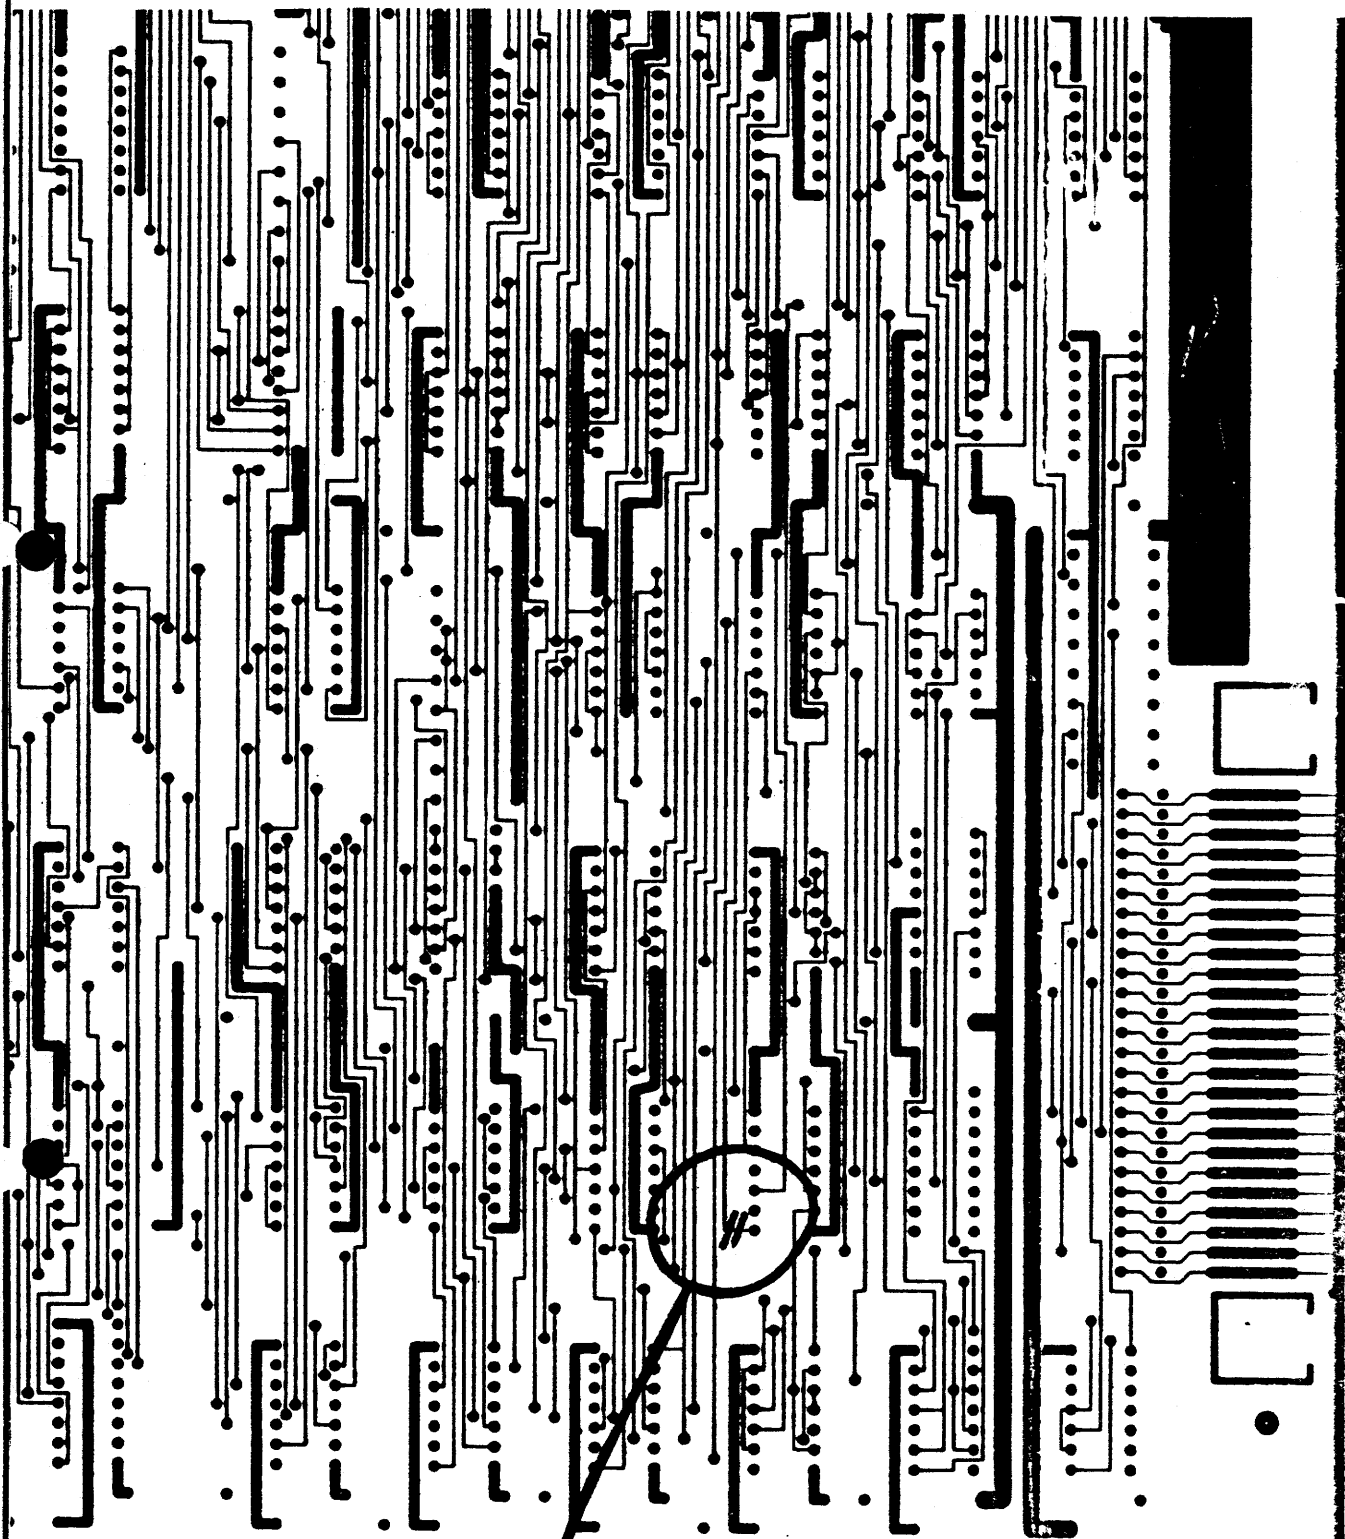


RC 2324

Cut foil path as indicated





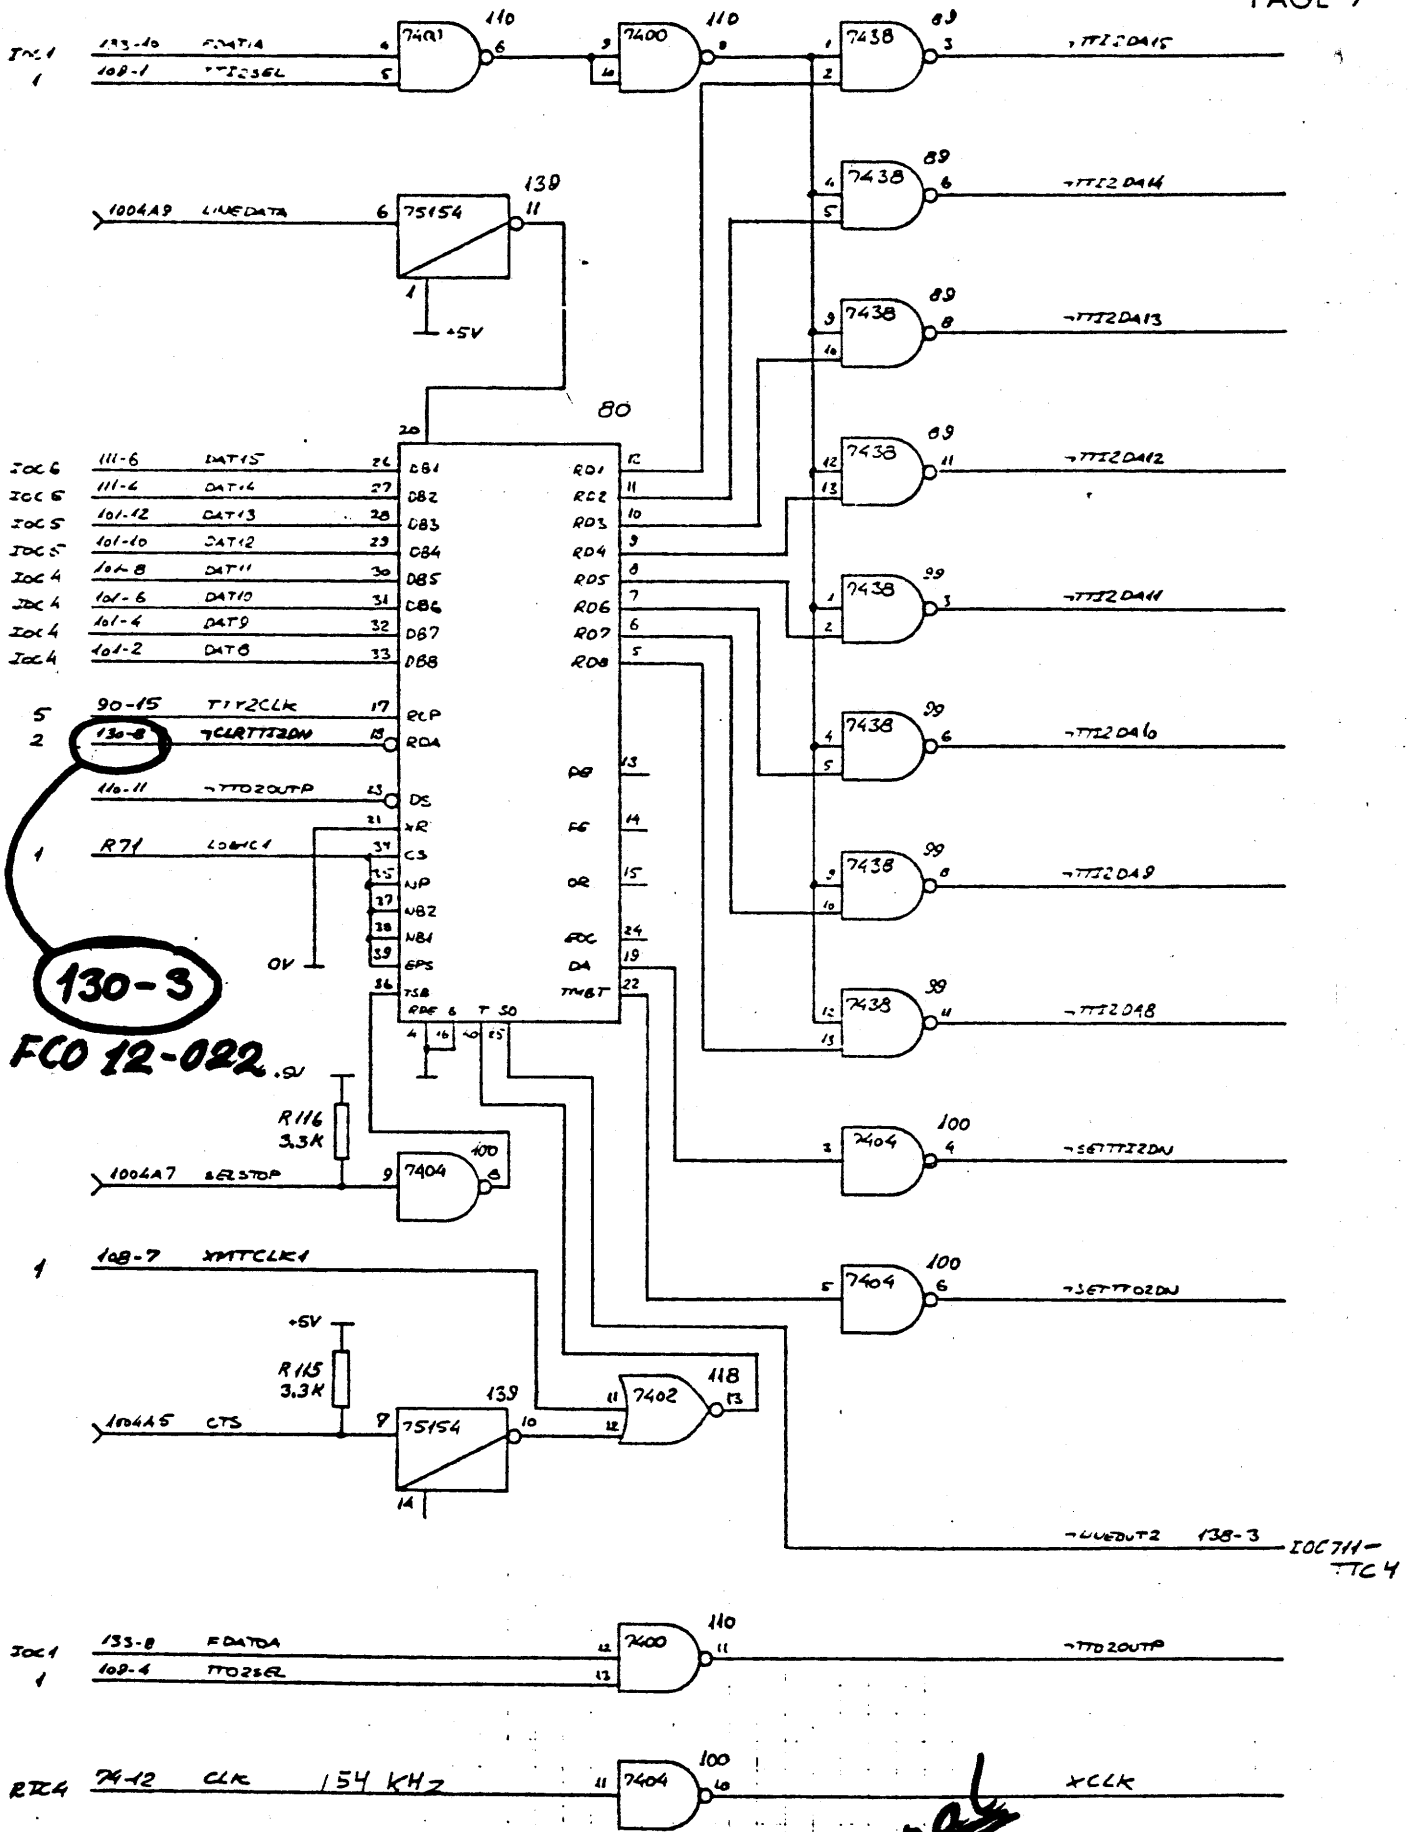

**130-3**  
**FCO 12-022**

*Provisional*

Replaces Dwg. No. R1190  
 due to ECN  
 Design Check  
 Dwg. Office  
 Drawn by  
 Designed by 75.02.05 JJO  
 A/S REG. CENTRALEN

Unit TTCTH	RECEIVER AND TRANSMITTER LOGIC	TTCTH 4
Dwg. No.	LOGIC DIAGRAM	